#### PLUMBING GENERAL NOTES EXISTING PIPING AND EQUIPMENT TO REMAIN IS SHOWN LIGHT. NEW PIPING AND EQUIPMENT IS SHOWN HEAVY. EXISTING PIPING AND EQUIPMENT TO BE REMOVED IS SHOWN DASHED. 1 ARCHITECTURAL DRAWINGS SHALL BE REVIEWED FOR PROJECT SCOPE AND AREA OF WORK. WORK SHALL INCLUDE DEMOLITION AND REMOVAL OF EXISTING PLUMBING FIXTURES AS REQUIRED. PLUMBING IN EXISTING WALLS AND UNDER GROUND SHALL BE REMOVED AND CAPPED AS REQUIRED. RECONNECT EXISTING PIPING TO FIXTURES AND EQUIPMENT NOT IN DEMOLITION AREA AS REQUIRED TO MAINTAIN A COMPLETE AND OPERABLE SYSTEM. THE OWNER RESERVES FIRST CHOICE TO KEEP EXISTING EQUIPMENT AND MATERIALS. COORDINATE WITH OWNER AND DELIVER DESIGNATED EQUIPMENT AND MATERIALS REMOVED UNDER THIS CONTRACT TO OWNERS DESIGNATED STORAGE AREA. REFER TO ARCHITECTURAL DRAWINGS FOR EXACT PLUMBING FIXTURE LOCATIONS, MOUNTING HEIGHTS, AND PLUMBING ROUGH-IN LOCATIONS. THIS SHALL INCLUDE, BUT NOT BE LIMITED TO, ALL HANDICAPPED FIXTURES. OBTAIN EXACT FLOOR DRAIN AND FLOOR SINK LOCATIONS FROM FOOD SERVICE DRAWINGS. ROUGH-IN LOCATIONS FOR KITCHENS, BARS, ETC. TO BE TAKEN FROM APPROVED FOOD SERVICE SHOP ITEM DESIGNATIONS INDICATED ARE FOR PURPOSES OF THESE DOCUMENTS ONLY. CONTRACTOR SHALL VERIFY WITH OWNER ACTUAL DESIGNATION INFORMATION TO BE PROVIDED FOR EACH ITEM OF PLUMBING EQUIPMENT PRIOR TO NAMEPLATE ORDER RELEASE. THE PLUMBING DETAILS SHALL BE CONSIDERED AS A PART OF THE CONTRACT DOCUMENTS. THESE DETAILS SHALL BE INCORPORATED INTO THE ASSOCIATED WORK AND PROVIDE GENERAL GUIDANCE AS TO THE INSTALLATION INTENT WHETHER REFERENCED TO OR NOT. IT IS THE CONTRACTOR'S RESPONSIBILITY TO PROVIDE ALL NECESSARY COMPONENTS FOR A COMPLETE INSTALLATION AND ENSURE THAT ALL INSTALLATIONS ARE IN ACCORDANCE WITH THE EQUIPMENT'S LISTING AND THE MANUFACTURER'S WRITTEN INSTALLATION INSTRUCTIONS. DO NOT SCALE DRAWINGS. WATER PIPING SHALL BE ROUTED "AROUND" ELECTRICAL ROOMS. PROVIDE SHEET METAL DRAIN PAN UNDER GRAVITY OR PUMPED DRAIN PIPING WHERE PIPING OCCURS ABOVE KITCHENS, FOOD SERVICE PREP, OR FOOD SERVICE CORRIDORS. PIPE 3/4" DRAIN FROM DRAIN PAN TO OVER NEAREST FLOOR SINK. PROVIDE SHEET METAL DRAIN PAN UNDER PIPING WHERE PIPING OCCURS ABOVE ANY ELECTRICAL ROOMS, INFORMATION TECHNOLOGY (I/T) CENTER, OR ELECTRICAL SWITCH GEAR PIPE 3/4" DRAIN FROM DRAIN PAN TO OVER NEAREST FLOOR SINK. REFER TO CIVIL DRAWINGS FOR INVERT AT SITE UTILITY POINTS OF CONNECTION. PROVIDE INCREASER FOR STORM DRAIN OR SEWER AS REQUIRED FOR CONNECTION TO CIVIL. 12. INSULATED PIPING EXPOSED TO VIEW THEROUGHOUT THE FACILITY (EXCLUDING JANITORS CLOSETS AND MECHANICAL ROOMS) SHALL B COVERED AND FINISHED WITH PVC JACKET EQUAL TO MANVILL PVC / PERMAPIPE JACKETING SYSTEM USING 30 MIL THICK JACKET. INSTALL PER MANUFACTURER'S INSTRUCTIONS WITH SEAM ON TOP OF PIPE SO AS TO NOT BE VISIBLE FROM OCCUPIED SPACE. 13. SEISMIC RESTRAINTS SHALL BE PROVIDED PER THE 2009 IBC, VA SPECIFICATIONS SECTION 130541, AND THE SMACNA SEISMIC RESTRAINT MANUAL - GUIDELINES FOR MECHANICAL SYSTEMS. THE CONTRACTOR SHALL SUBMIT SHOP DRAWINGS OF THE PROPOSED RESTRAINTS, STRUCTURAL ATTACHMENT METHODS AND RESTRAINT LOCATIONS TO THE ARCHITECT FOR REVIEW AND APPROVAL. THE SUBMITTED DOCUMENTS SHALL BE PREPARED AND STAMPED BY A STRUCTURAL ENGINEER LICENSED IN THE STATE OF NEVADA. VI INLVADA. 14. COORDINATE SPRINKLER/STANDPIPE DRAIN REQUIREMENTS AND LOCATIONS WITH FIRE PROTECTION 15. PROVIDE TRAP PRIMERS FOR AREAS OF INFREQUENT USE, INCLUDING FLOOR DRAINS IN RESTROOMS AND MECHANICAL ROOMS, WITH DISTRIBUTION UNITS FOR MULTIPLE FLOOR DRAINS AND FLOOR SINKS. TRAP PRIMER SHALL BE ACCESSIBLE AND INSTALLED PER MANUFACTURER'S REQUIREMENTS. PROVIDE - LINE SIZE SHUT-OFF VALVE AHEAD OF EACH TRAP PRIMER. ALL ELECTRONIC TYPE TRAP PRIMERS SHALL-HAVE 4 TO 30 OUTLETS, VACUUM BREAKER, 24 HOUR CLOCK, MANUAL OVERRIDE, SOLENOID VALVE, CALIBRATED MANIFOLD WITH 1/2" OUTLET COMPRESSION FITTINGS. PROVIDE 3/4" SHUT-OFF VALVE ON INLET. (ELECTRONIC TRAP PRIMERS TO BE LOCATED IN MECHANICAL ROOMS AND WHERE NOTED. PROVIDE RECESSED MOUNT IN STUD WALLS AND SURFACE MOUNT ON CONCRETE AND BLOCK WALLS.) REFER TO FLOW CONTROL VALVE DETAIL FOR NOMINAL GPM AT EACH HOT WATER RETURN BRANCH LINE CONNECTION. HOT WATER-RETURN PIPING BRANCH LINES TO DROP DOWN IN WALL AND CONNECT TO HOT WATER SUPPLY AT STOPS. REFER TO DETAIL SHEET FOR DIAGRAMS SHOWING CONNECTIONS. 18. ARRANGE WATER HEATERS AND PIPING TO PROVIDE EASE OF DISASSEMBLY AND MAINTENANCE. 19. PLUMBING RISERS, DRAIN STACKS, AND BRANCH PIPING OFF MAINS SHALL BE COORDINATED WITH MECHANICAL DUCTWORK, MECHANICAL PIPING, AND FIRE PROTECTION PIPING SYSTEMS. 20. INSTALL PIPING HIGH AS POSSIBLE. 21. INDUSTRIAL COLD WATER PIPING SERVING LANDSCAPE PLANTERS AND TREES SHALL BE SUPPLIED THROUGH BACKFLOW PREVENTER BY LANDSCAPE SECTION. REFER TO LANDSCAPE DRAWINGS FOR FINAL STUB-UP AND TERMINATION SERVING ALL PLANTERS AND STATIONS. 22. PROVIDE A 6 MIL. POLYETHYLENE SLEEVE EQUAL TO IPS WATER-TITE FOR COPPER DOMESTIC WATER PIPE BELOW SLAB. 23. HOT AND COLD WATER SHUT-OFF VALVES AND HOT WATER RETURN THROTTLING VALVES SHALL BE LOCATED TO BE EASILY ACCESSED. 24. PROVIDE WALL CLEANOUTS AT SINKS AND URINALS IN ACCORDANCE WITH APPLICABLE SECTIONS OF 2009 UNIFORM PLUMBING CODE.

25. REFER TO MIXING VALVE DETAIL FOR LAVATORY/SINK TEMPERED WATER DETAIL. PROVIDE

26. VENTS THROUGH ROOF SHALL BE MINIMUM 10'-0" FROM ANY OUTSIDE AIR INTAKES AND BUILDING

THERMOSTATIC TYPE MIXING VALVE AS INDICATED.

OPENINGS.

VA FORM 08-623

ABBR	SYMBOL	DESCRIPTION
		SHEET NOTE
		REVISION NUMBER
	/1\	
OR W		SOIL, WASTE OR SEWER BELOW GRADE OR FLOOR
OR W	SD	SOIL, WASTE OR SEWER ABOVE GRADE OR FLOOR
SD		STORM DRAIN ABOVE OR ARE OR FLOOR
SD	SD	STORM DRAIN ABOVE GRADE OR FLOOR
OSD	OSD	OVERFLOW STORM DRAIN ABOVE OR ARE OR FLOOR
OSD	——OSD——	OVERFLOW STORM DRAIN ABOVE GRADE OR FLOOR
V		VENT
SCW		SOFT COLD WATER (440%E)
SHW		SOFT HOT WATER RETURN (440°F)
SHWR		SOFT HOT WATER RETURN (140°F)
STW		SOFT TEMPERED WATER RETURN (405°F)
STWR		SOFT TEMPERED WATER RETURN (105°F)
FCW		FILTERED COLD WATER
PD	PD	PUMPED DRAIN
DW	D	DRAIN  DUMBED WASTE BELOW CRADE OR ELOOP
PW	PW	PUMPED WASTE BELOW GRADE OR FLOOR
ICW	ICW———	INDUSTRIAL COLD WATER
LPS	LPS——	LOW PRESSURE STEAM (15 PSI)
HPS F	——————————————————————————————————————	HIGH PRESSURE STEAM (125 PSI)
<del>-</del>	'	FIRE LINE
CSP	CSP	COMBINATION STAND PIPE
		PIPING BELOW GRADE WITH HEAT TRACE
00)/		PIPING ABOVE GRADE WITH HEAT TRACE
SOV		SHUT-OFF VALVE
BVA	——————————————————————————————————————	BALANCING VALVE
CV		CHECK VALVE
	X <sub>4</sub>	STRAINER
DC		UNION
PG	— <u></u> >—≫—⊘	PRESSURE GAUGE
	<u></u>	SOLENOID VALVE  RELIEF VALVE
	T	PIPE REDUCTER
HB	+C	HOSE BIBB
RHB		RECESSED HOSE BIBBS
КПБ		FLEXIBLE PIPE CONNECTION
	——————————————————————————————————————	REDUCED PRESSURE BACKFLOW PREVENTER
WHA	•	WATER HAMMER ARRESTOR
TH		THERMOMETER
CO	Φ	CLEANOUT
WCO	Ψ I—	WALL CLEANOUT
FD	□ 'I'—	FLOOR DRAIN
FS		FLOOR SINK
RD	©	ROOF DRAIN
ORD	<u> </u>	OVERFLOW ROOF DRAIN
VTR	0	VENT THRU ROOF
FDC		FIRE DEPARTMENT CONNECTION
FSR	— F——	FIRE SPRINKLER RISER
. •. •		PIPE DOWN
		PIPE UP
		PIPE TEE UP
		PIPE TEE DOWN
	×	ANCHOR
		GUIDE
POC	•	POINT OF CONNECTION TO EXISTING
POD	$\otimes$	POINT OF CONNECTION TO EXISTING  POINT OF DISCONNECTION FROM EXISTING
SLS	SLS	SOLAR LOOP SUPPLY
OLO	J	OOLAN LOOF OUT LT

	PLUMBING ABE (THIS IS A MASTER LIST, NOT ALL ABBE	<b>BREVI</b>	ATION LIST S MAY APPEAR ON DRAWINGS)
AFF AP AUTO AD	ABOVE FINISH FLOOR ACCESS PANEL AUTOMATIC ACCESS DOOR / AREA DRAIN	MBH MAX MC	1000 BRITISH THERMAL UNITS PER HOUR MAXIMUM MECHANICAL CONTRACTOR
BTU BOS BOH BMS	BRITISH THERMAL UNIT BOTTOM OF STEEL BACK OF HOUSE BUILDING MANAGEMENT SYSTEM	MCA MOCP MCC MIN MH	MINIMUM CIRCUIT AMPS MAXIMUM OVER CURRENT PROTECTION MOTOR CONTROL CENTER MINIMUM MANHOLE
C CFM CFH CP	DEGREES CELSIUS CUBIC FEET PER MINUTE CUBIC FEET PER HOUR CHROME PLATED	NA NEC NFPA	NOT APPLICABLE NATIONAL ELECTRIC CODE NATIONAL FIRE PROTECTION ASSOCIATION
DDC DDCFP	DIRECT DIGITAL CONTROL DIRECT DIGITAL CONTROL FIELD PANEL	NIC NTS	NOT IN CONTRACT NOT TO SCALE
DC DIA	DIRECT CURRENT DIAMETER	OFCI	OWNER FURNISHED CONTRACTOR INSTALLED
DF DN DSN E EMCS EWC EFF ET	DRINKING FOUNTAIN DOWN DOWNSPOUT NOZZLE EXISTING ENERGY MANAGEMENT CONTROL SYSTEM ELECTRIC WATER COOLER EFFICIENCY EXPANSION TANK	PH PA PRV PSI PSIA PSIG PD PDI	PHASE PRESSURE AVAILABLE PRESSURE REDUCING VALVE POUNDS PER SQUARE INCH POUNDS PER SQUARE INCH ABSOLUTE POUNDS PER SQUARE INCH GAUG PRESSURE DROP PLUMBING DRAINAGE INSTITUTE
°F FLA FCO FPM FPS	DEGREES FARENHEIT FULL LOAD AMPS FLOOR CLEAN OUT FEET PER MINUTE FEET PER SECOND	POS P POC POD	PROVIDE BY OTHER SECTION PUMP POINT OF CONNECTION POINT OF DISCONNECT
FT FH FV FU	FEET / FLUSH TANK FIRE HYDRANT FLUSH VALVE FIXTURE UNITS	RPM RR S	REVOLUTIONS PER MINUTE ROOF RECEPTICAL SINK
GAL GC GPM GPH	GALLONS GENERAL CONTRACTOR GALLONS PER MINUTE GALLONS PER HOUR	SH SOV SP SS SQ FT	SHOWER / STATIC HEAD SHUT-OFF VALVE STATIC PRESSURE STAINLESS STEEL / SERVICE SINK SQUARE FEET
HD HP HR HS HZ HOA	HEAD HORSE POWER HOUR HAND SINK HERTZ HAND OFF AUTO	T TAB TEL TP TOS TYP TS TDH	TEMPERATURE TESTING AND BALANCING TOTAL EQUIVALENT LENGTH TRAP PRIMER TOP OF STEEL TYPICAL TEMPERING STATION TOTAL DEVELOPED HEAD
IBC IMC IPC IE	INTERNATIONAL BUILDING CODE INTERNATIONAL MECHANICAL CODE INTERNATIONAL PLUMBING CODE INVERT ELEVATION	TW U UMC	TEMPERED WATER  URINAL  UNIFORM MECHANICAL CODE
KW	KILOWATT	UPC UNO	UNIFORM PLUMBING CODE UNLESS NOTED OTHERWISE
LAV/L LBS	LAVATORY POUNDS	V	VENTS / VOLTS
		WC WG WFU WH WP WPD	WATER CLOSET WATER GAUGE WATER FIXTURE UNITS WATER HEATER WATER PRESSURE WATER PRESSURE DROP


ISSU	JE			
	ADDE	05-07-2012 - CD2 Submittal	Sheet Number	SHEET DESCRIPTION
	•	•	PP-001	Plumbing - Sheet Index, Notes, Legend and Abbreviations
	•	•	PS-101	Plumbing Plan - Site
	•	•	PP-100A	Plumbing Plan - Basement Level - Admin - Domestic Water
		•	PP-100C	Plumbing Plan - Basement Level - Connector - Domestic Water
	•	•	PP-101A	Plumbing Plan - Level 1 - Admin - Domestic Water
	•	•	PP-101B	Plumbing Plan - Level 1 - Education Center - Domestic Water
	•	•	PP-102A	Plumbing Plan - Level 2 - Admin - Domestic Water
	•	•	PP-102B	Plumbing Plan - Roof - Education Center - Domestic Water
	•	•	PP-103A	Plumbing Plan - Level 3 - Admin - Domestic Water
	•	•	PP-104A	Plumbing Plan - Roof - Admin - Domestic Water
	•	•	PL-100A	Plumbing Plan - Basement Level - Admin - Waste and Vent
	•	•	PL-101A	Plumbing Plan - Level 1 - Admin - Waste and Vent
	•	•	PL-101B	Plumbing Plan - Level 1 - Education Center - Waste and Vent
		•	PL-101C	Plumbing Plan - Level 1 - Connector - Waste and Vent
	•	•	PL-102A	Plumbing Plan - Level 2 - Admin - Waste and Vent
	•	•	PL-102B	Plumbing Plan - Roof - Education Center - Waste and Vent
		•	PL-102C	Plumbing Plan - Level 2 - Connector - Waste and Vent
	•	•	PL-103A	Plumbing Plan - Level 3 - Admin - Waste and Vent
		•	PL-103C	Plumbing Plan - Level 3 - Connector - Waste and Vent
	•	•	PL-104A	Plumbing Plan - Roof - Admin - Waste and Vent
		•	PL-104C	Plumbing Plan - Roof - Connector - Waste and Vent
	•	•	PP-201	Enlarged Plumbing Plans - Level 1 - Education Center Restrooms
	•	•	PP-202	Enlarged Plumbing Plans - Level 01 - Admin Restrooms
	•	•	PP-203 PP-204	Enlarged Plumbing Plans - Level 02 - Admin Restrooms
	•	•	PP-204 PP-205	Enlarged Plumbing Plans - Level 03 - Admin Restrooms
	•	•	PP-205 PL-301	Enlarged Plumbing Plans - Basement - Mechanical Room Waste and Vent Isometric - Admin
	•	•	PL-301	Waste and Vent Isometric - Admin  Waste and Vent Isometric - Education Center
		•	PL-311	Storm Drain Isometric - Admin
		•	PL-311	Storm Drain Isometric - Admin Storm Drain Isometric - Education Center
	•	•	PP-301	Domestic Water Isometric - Admin
	•	•	PP-302	Domestic Water Isometric - Admini
	•	•	PP-401	Plumbing - Details
	•	•	PP-402	Plumbing - Details
	•	•	PP-403	Plumbing - Details
	•	•	PP-404	Plumbing - Details
	•	•	PP-501	Plumbing - Schedules
	•	•	PP-502	Plumbing - Schedules
	•	•	PP-503	Plumbing - Schedules
		•	PP-601	Domestic and Solar Water Flow Diagrams


SHEET INDEX

CONSTRUCTION DOCUMENTS

BUILDING IS FULLY SPRINKLERED

Plumbing - Sheet Index, Notes, Legend **Project Number** CONSULTANTS: **Project Title** ADDENDUM 1 **KEY PLAN ARCHITECT/ENGINEERS:** Office of **VA Medical Center - PHASE** 593CA2202 and Abbreviations Construction V, Administration Bldg. & **Building Number** CIVIL: SLATER HANIFAN GROUP, 5740 S. ARVILLE ST. #216, LAS VEGAS, NV 89118 and J W ZUNINO LANDSCAPE ARCHITECTURE, 3191 S. JONES BLVD., LAS VEGAS, NV 89146 **Education Ctr. Addition** LANDSCAPE: RTKL JBA CONSULTING ENGINEERING, 5155 WEST PATRICK LANE, LAS VEGAS, NV 89118 **Facilities** STRUCTURAL DEGENKOLB ENGINEERING, 235 MONTGOMERY STREET, SUITE 500, SAN FRANSISCO CA 94104 Drawing Number **Approved: Project Director** NINYO AND MOORE, 6700 PARADISE ROAD, SUITE E, LAS VEGAS, NV 89119 **GEOTECHNICAL:** North Las Vegas, NV J M A A R CHITECTURE STUDIOS Management **PP-001** FIRE & LIFE SAFETY: LASALLE ENGINEERING, 1000 YORK ROAD, WILLOW GROVE, PA 19090 A Joint Venture Department of Veterans Affairs MAD **322** of **512** 

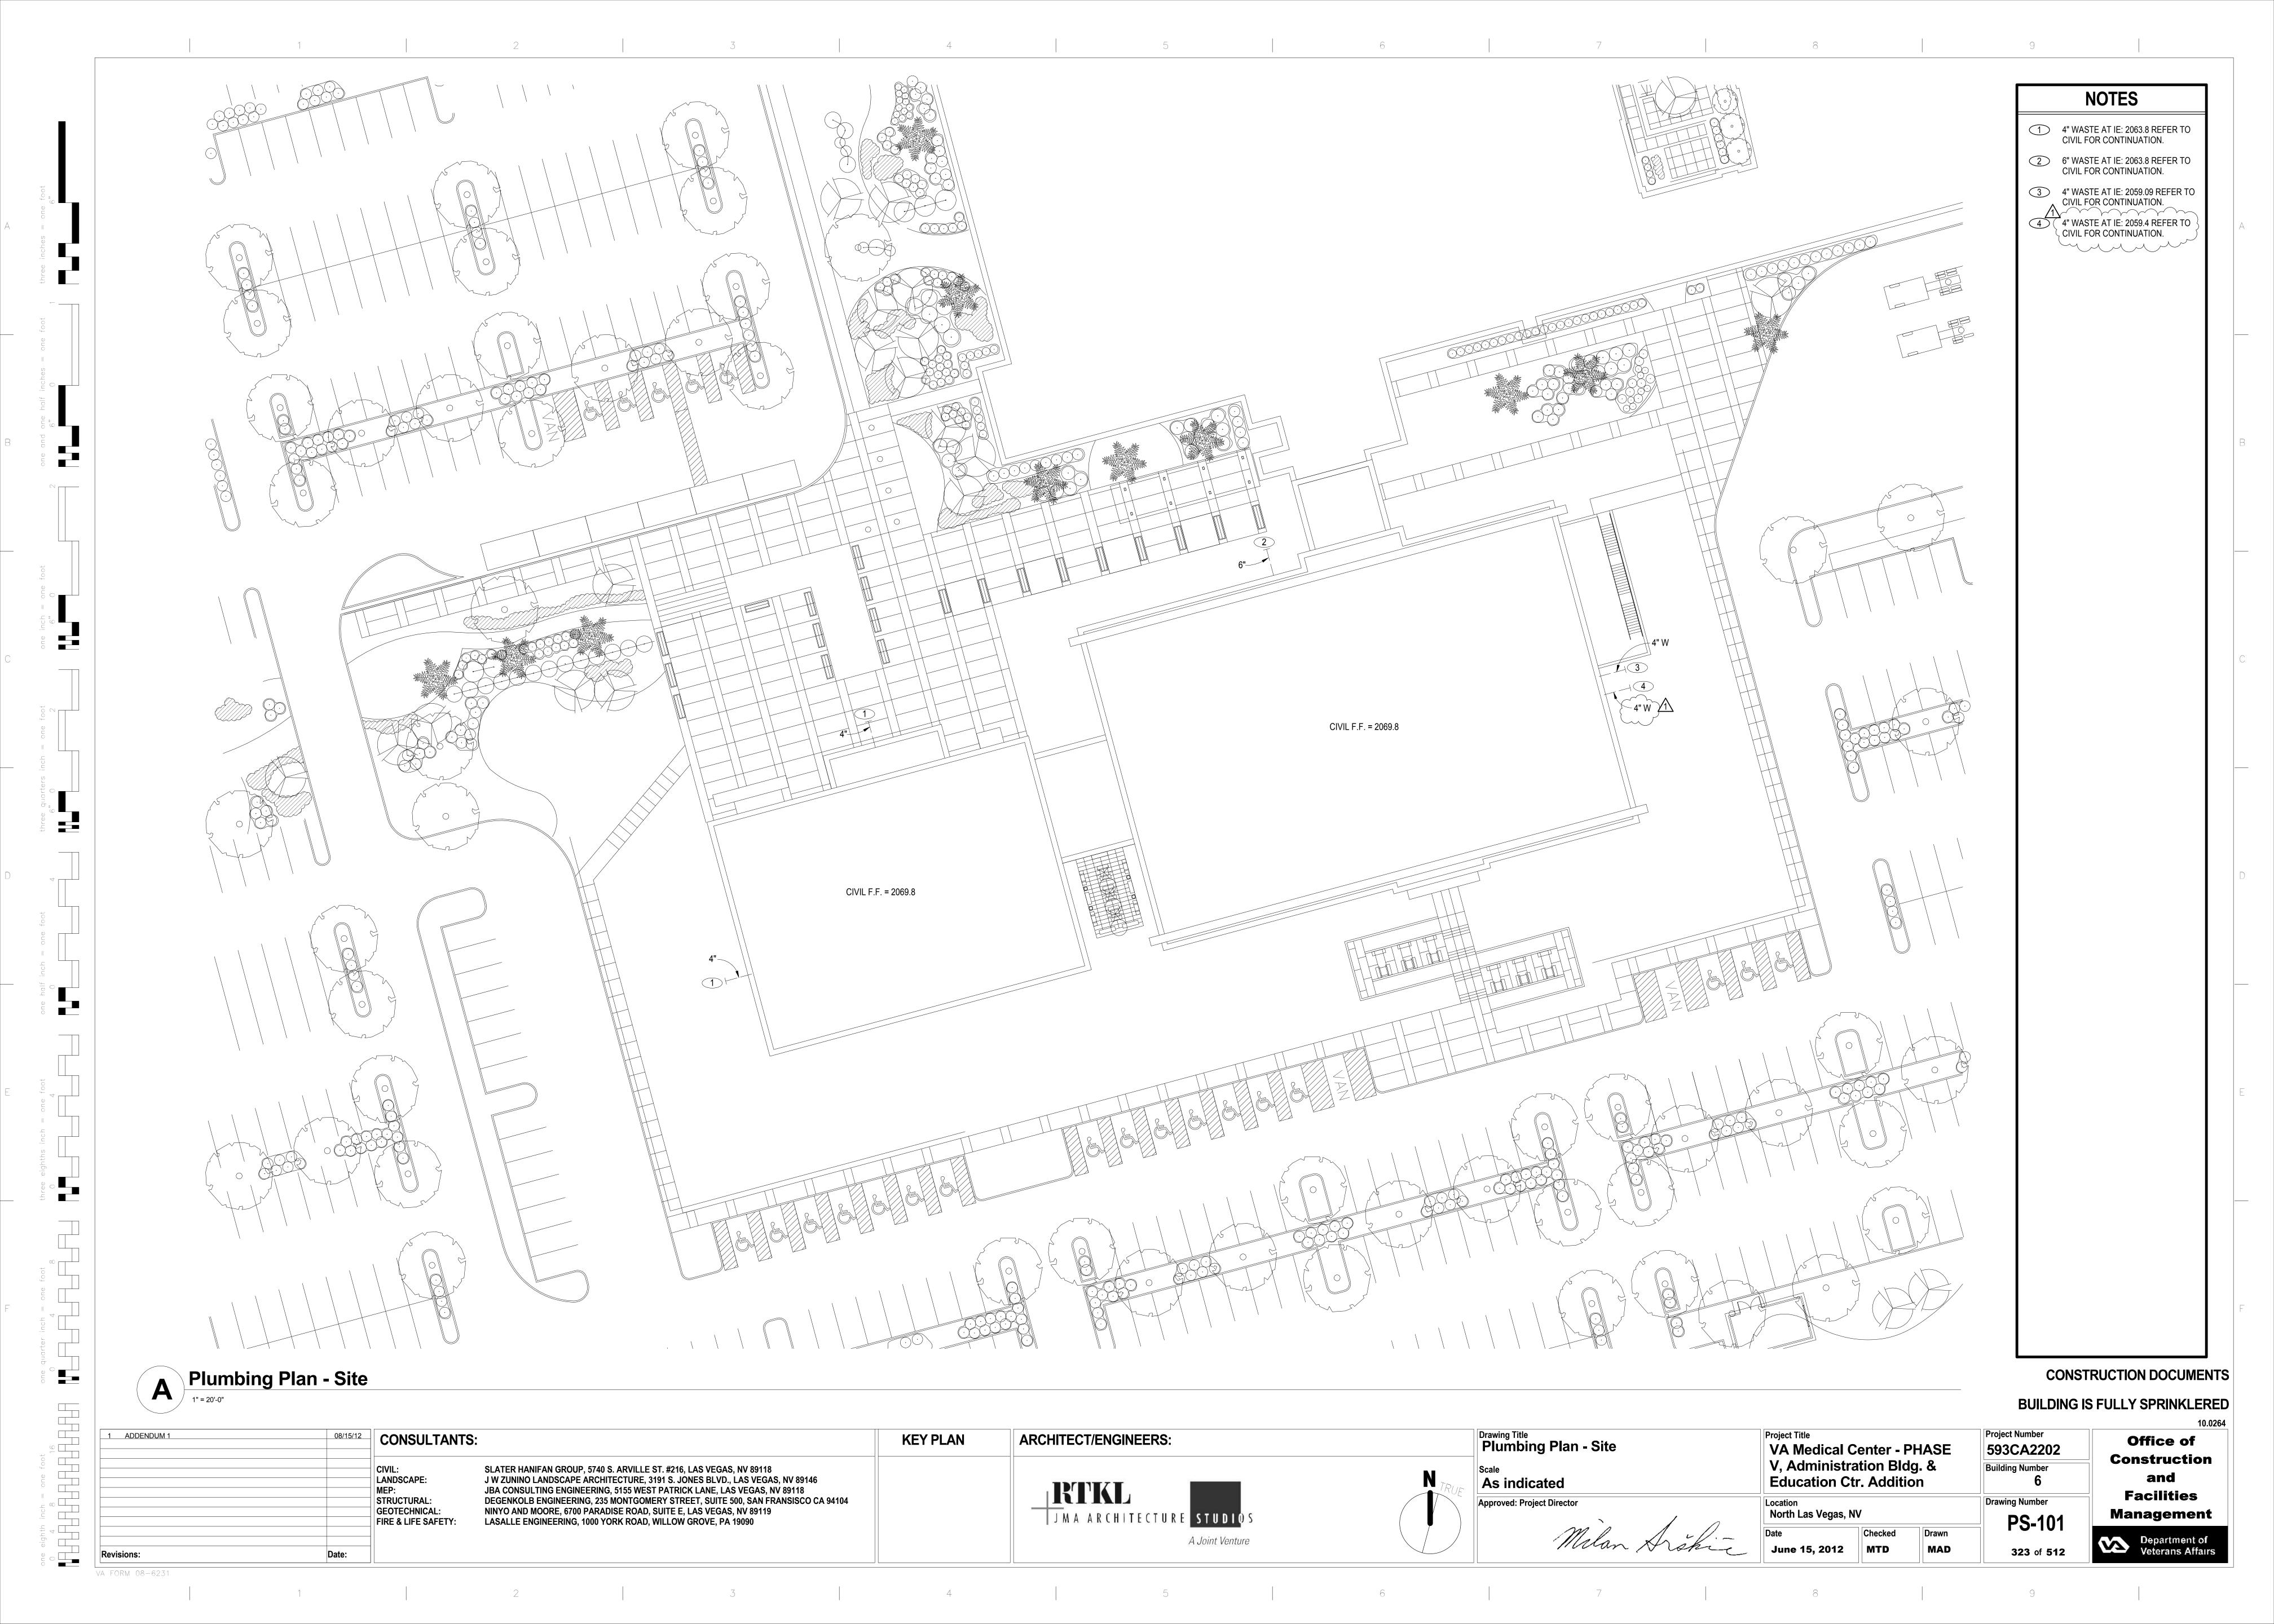


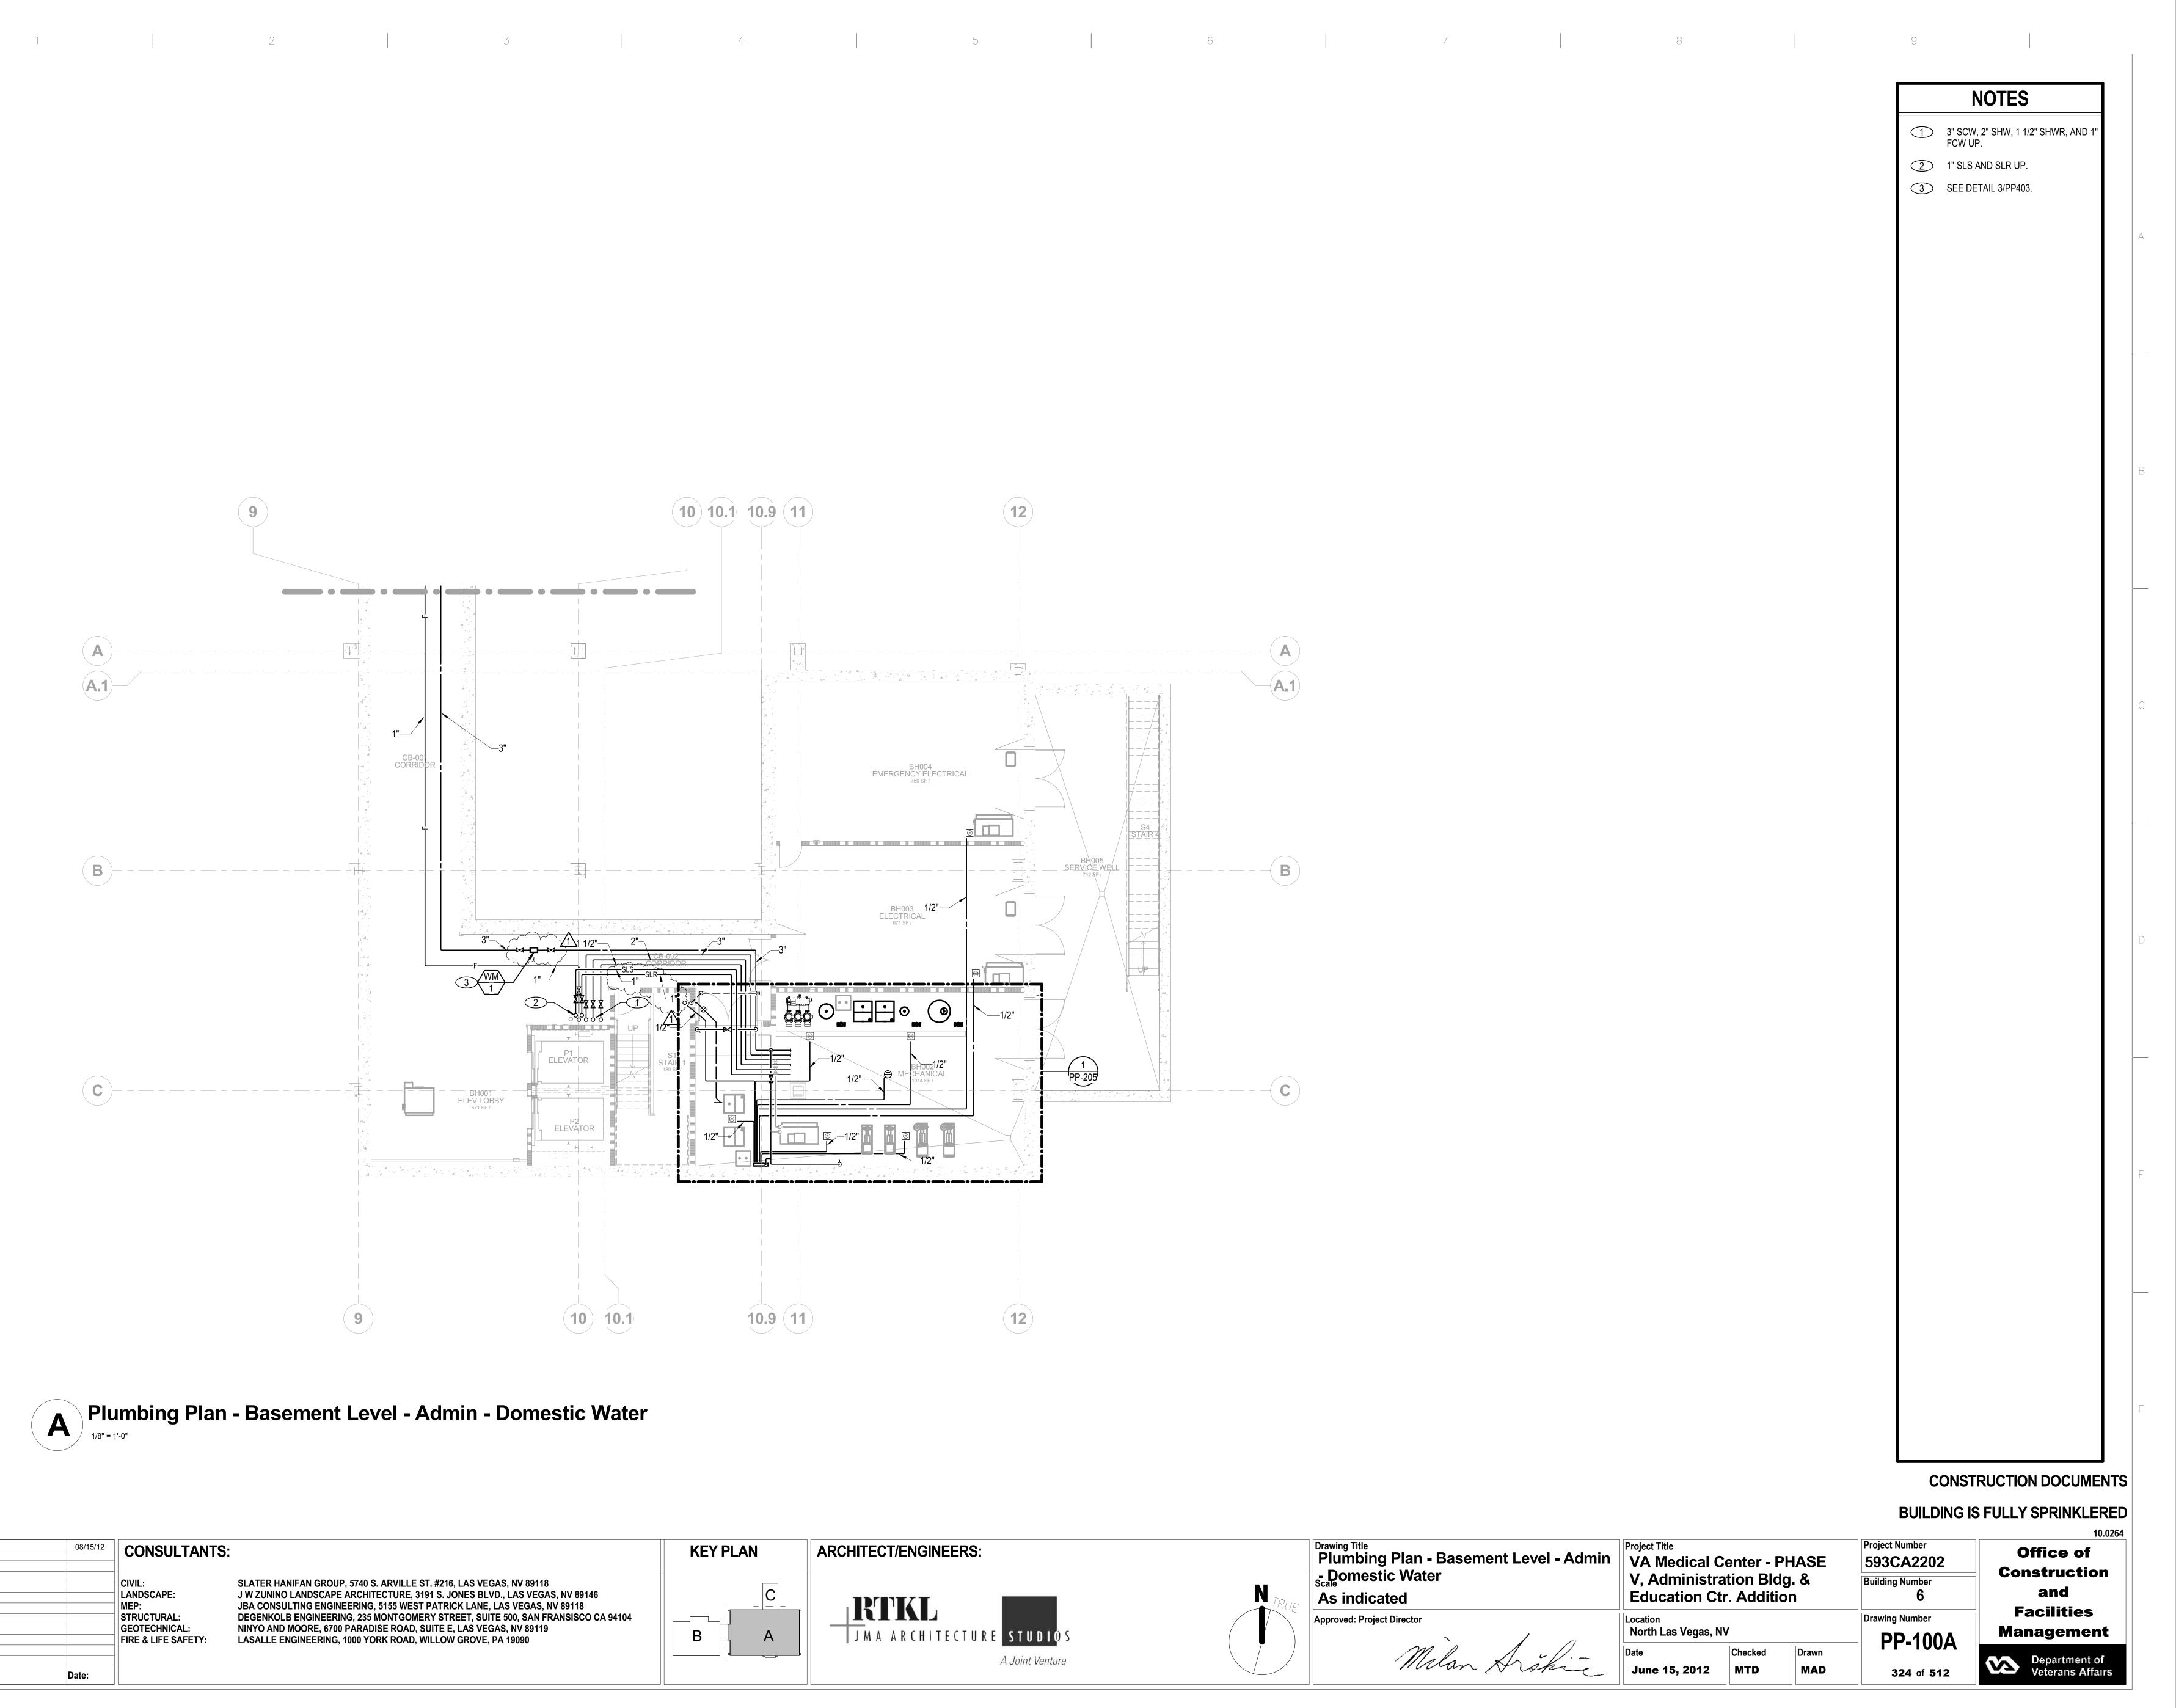


one eignin inch = one toot

4 8 16


ADDENDUM 1

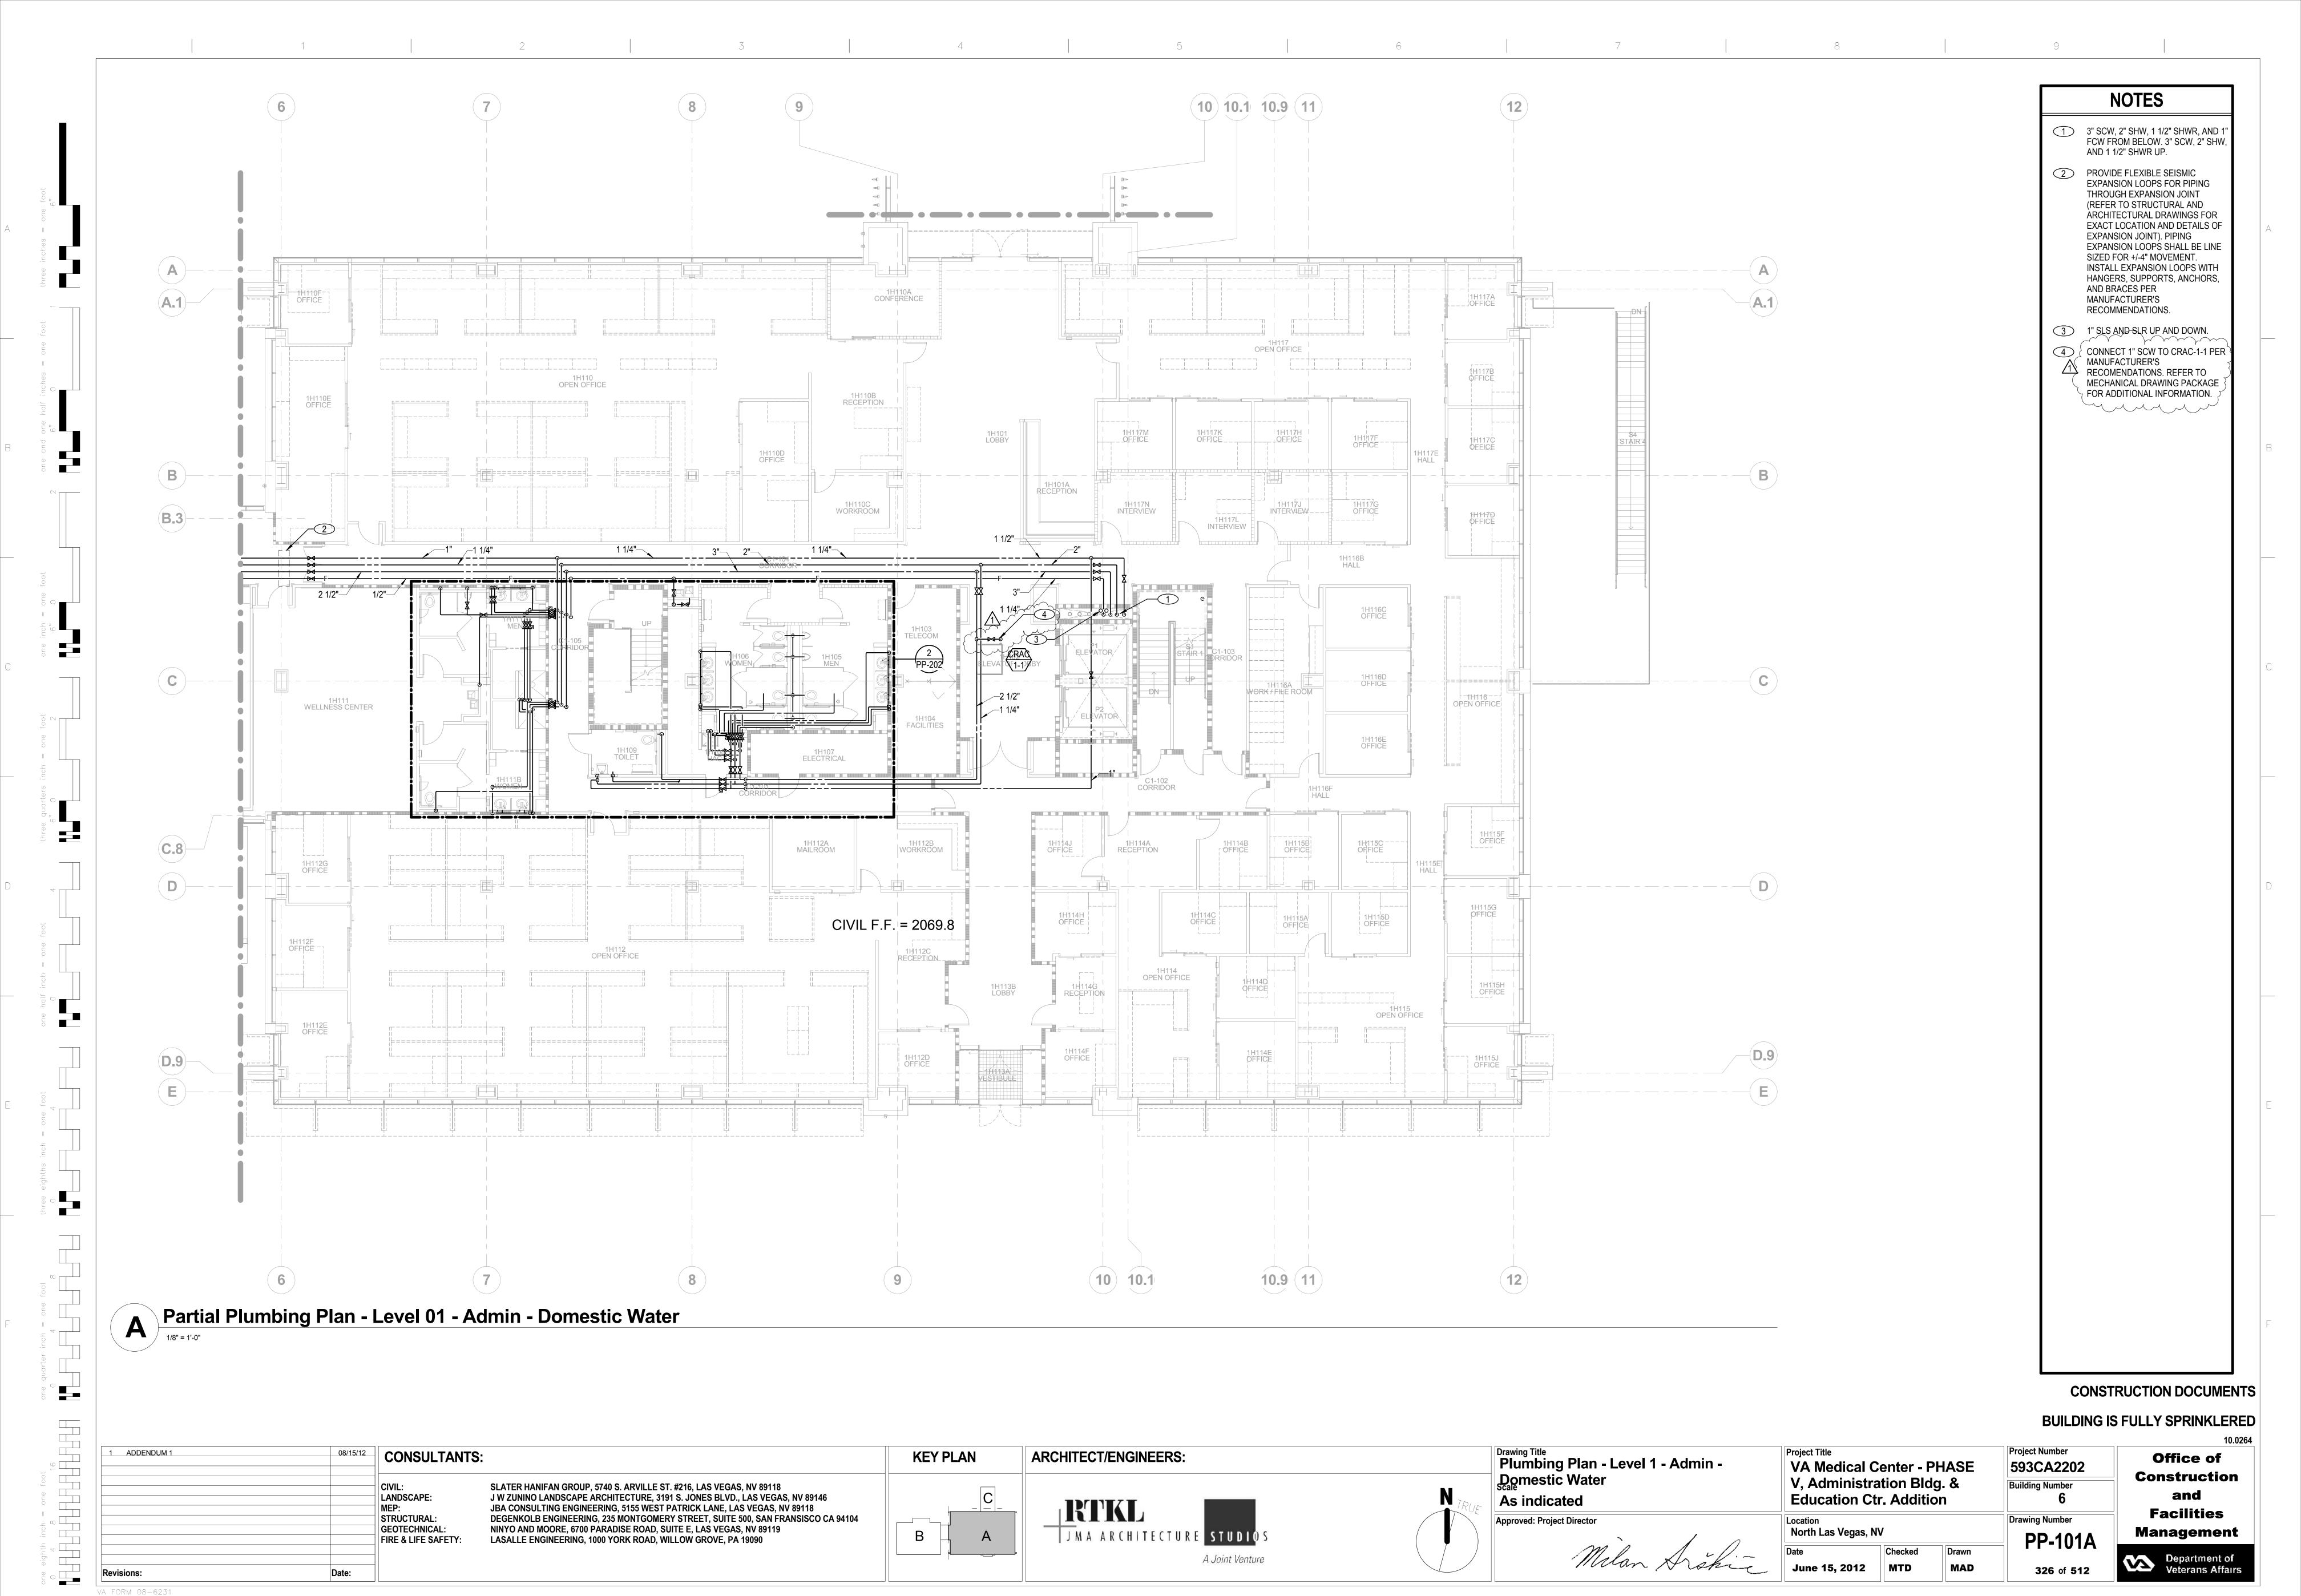


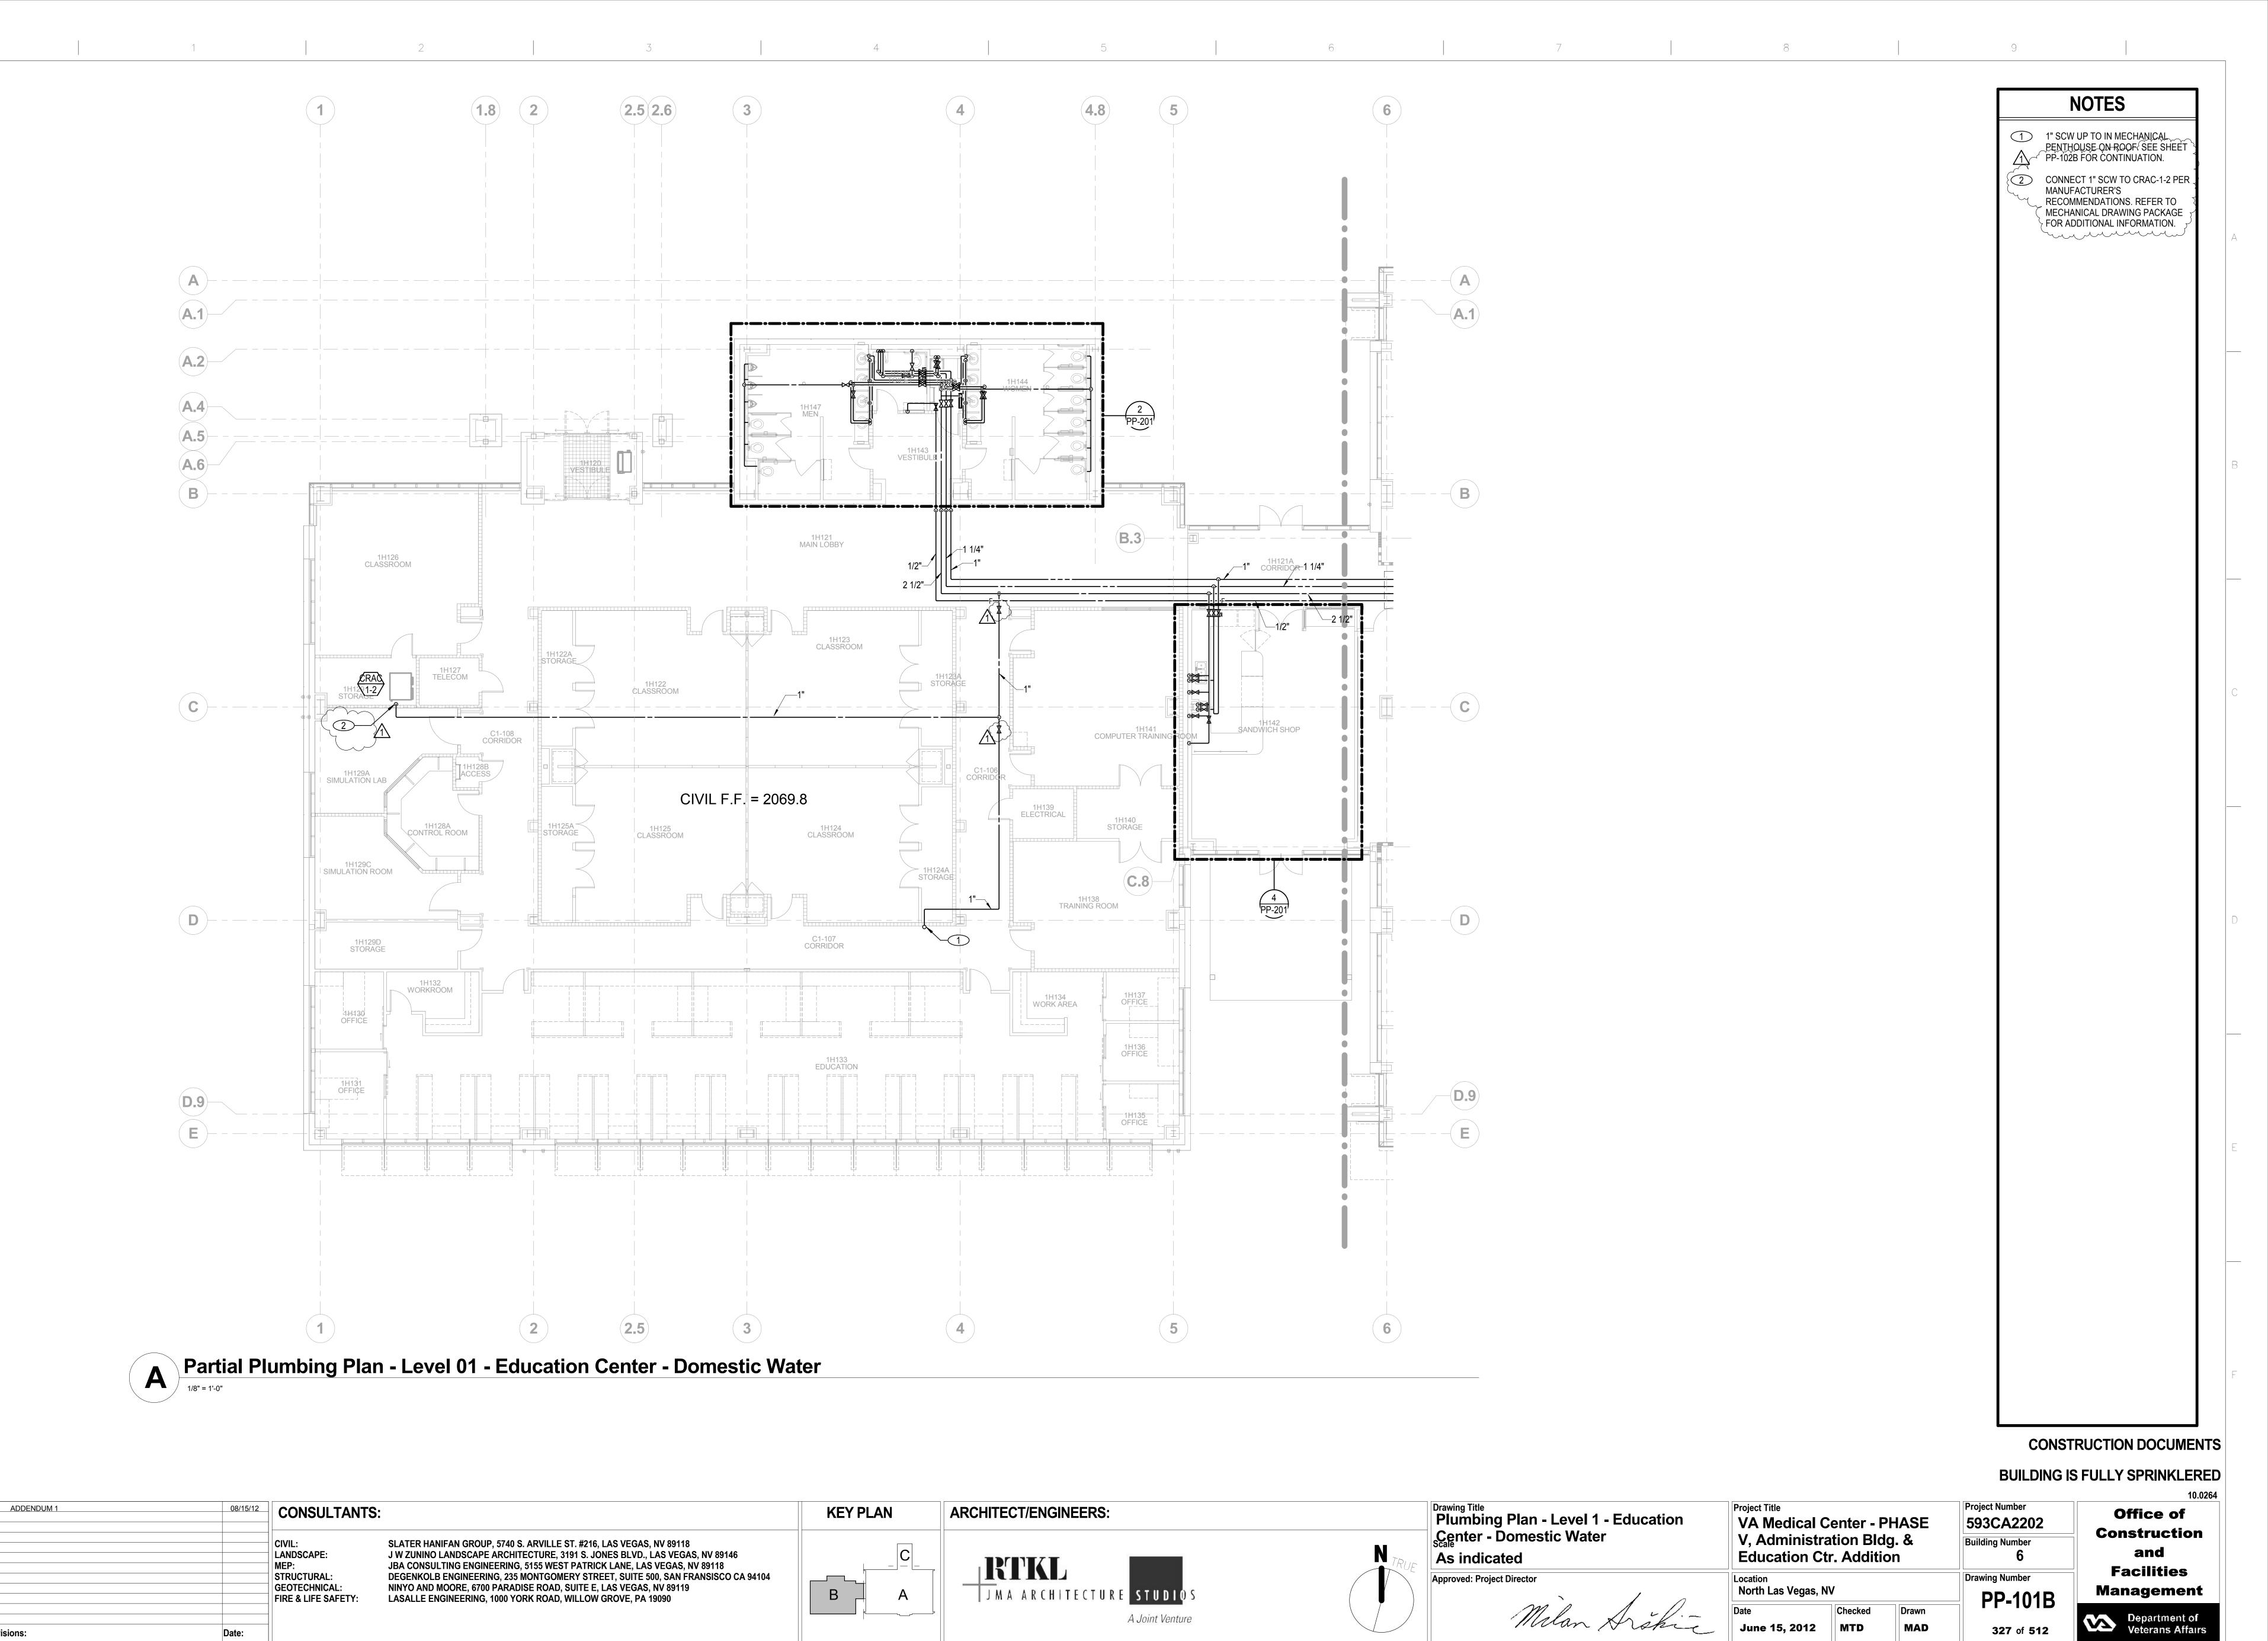


one eignin inch = one toot


4 8 16

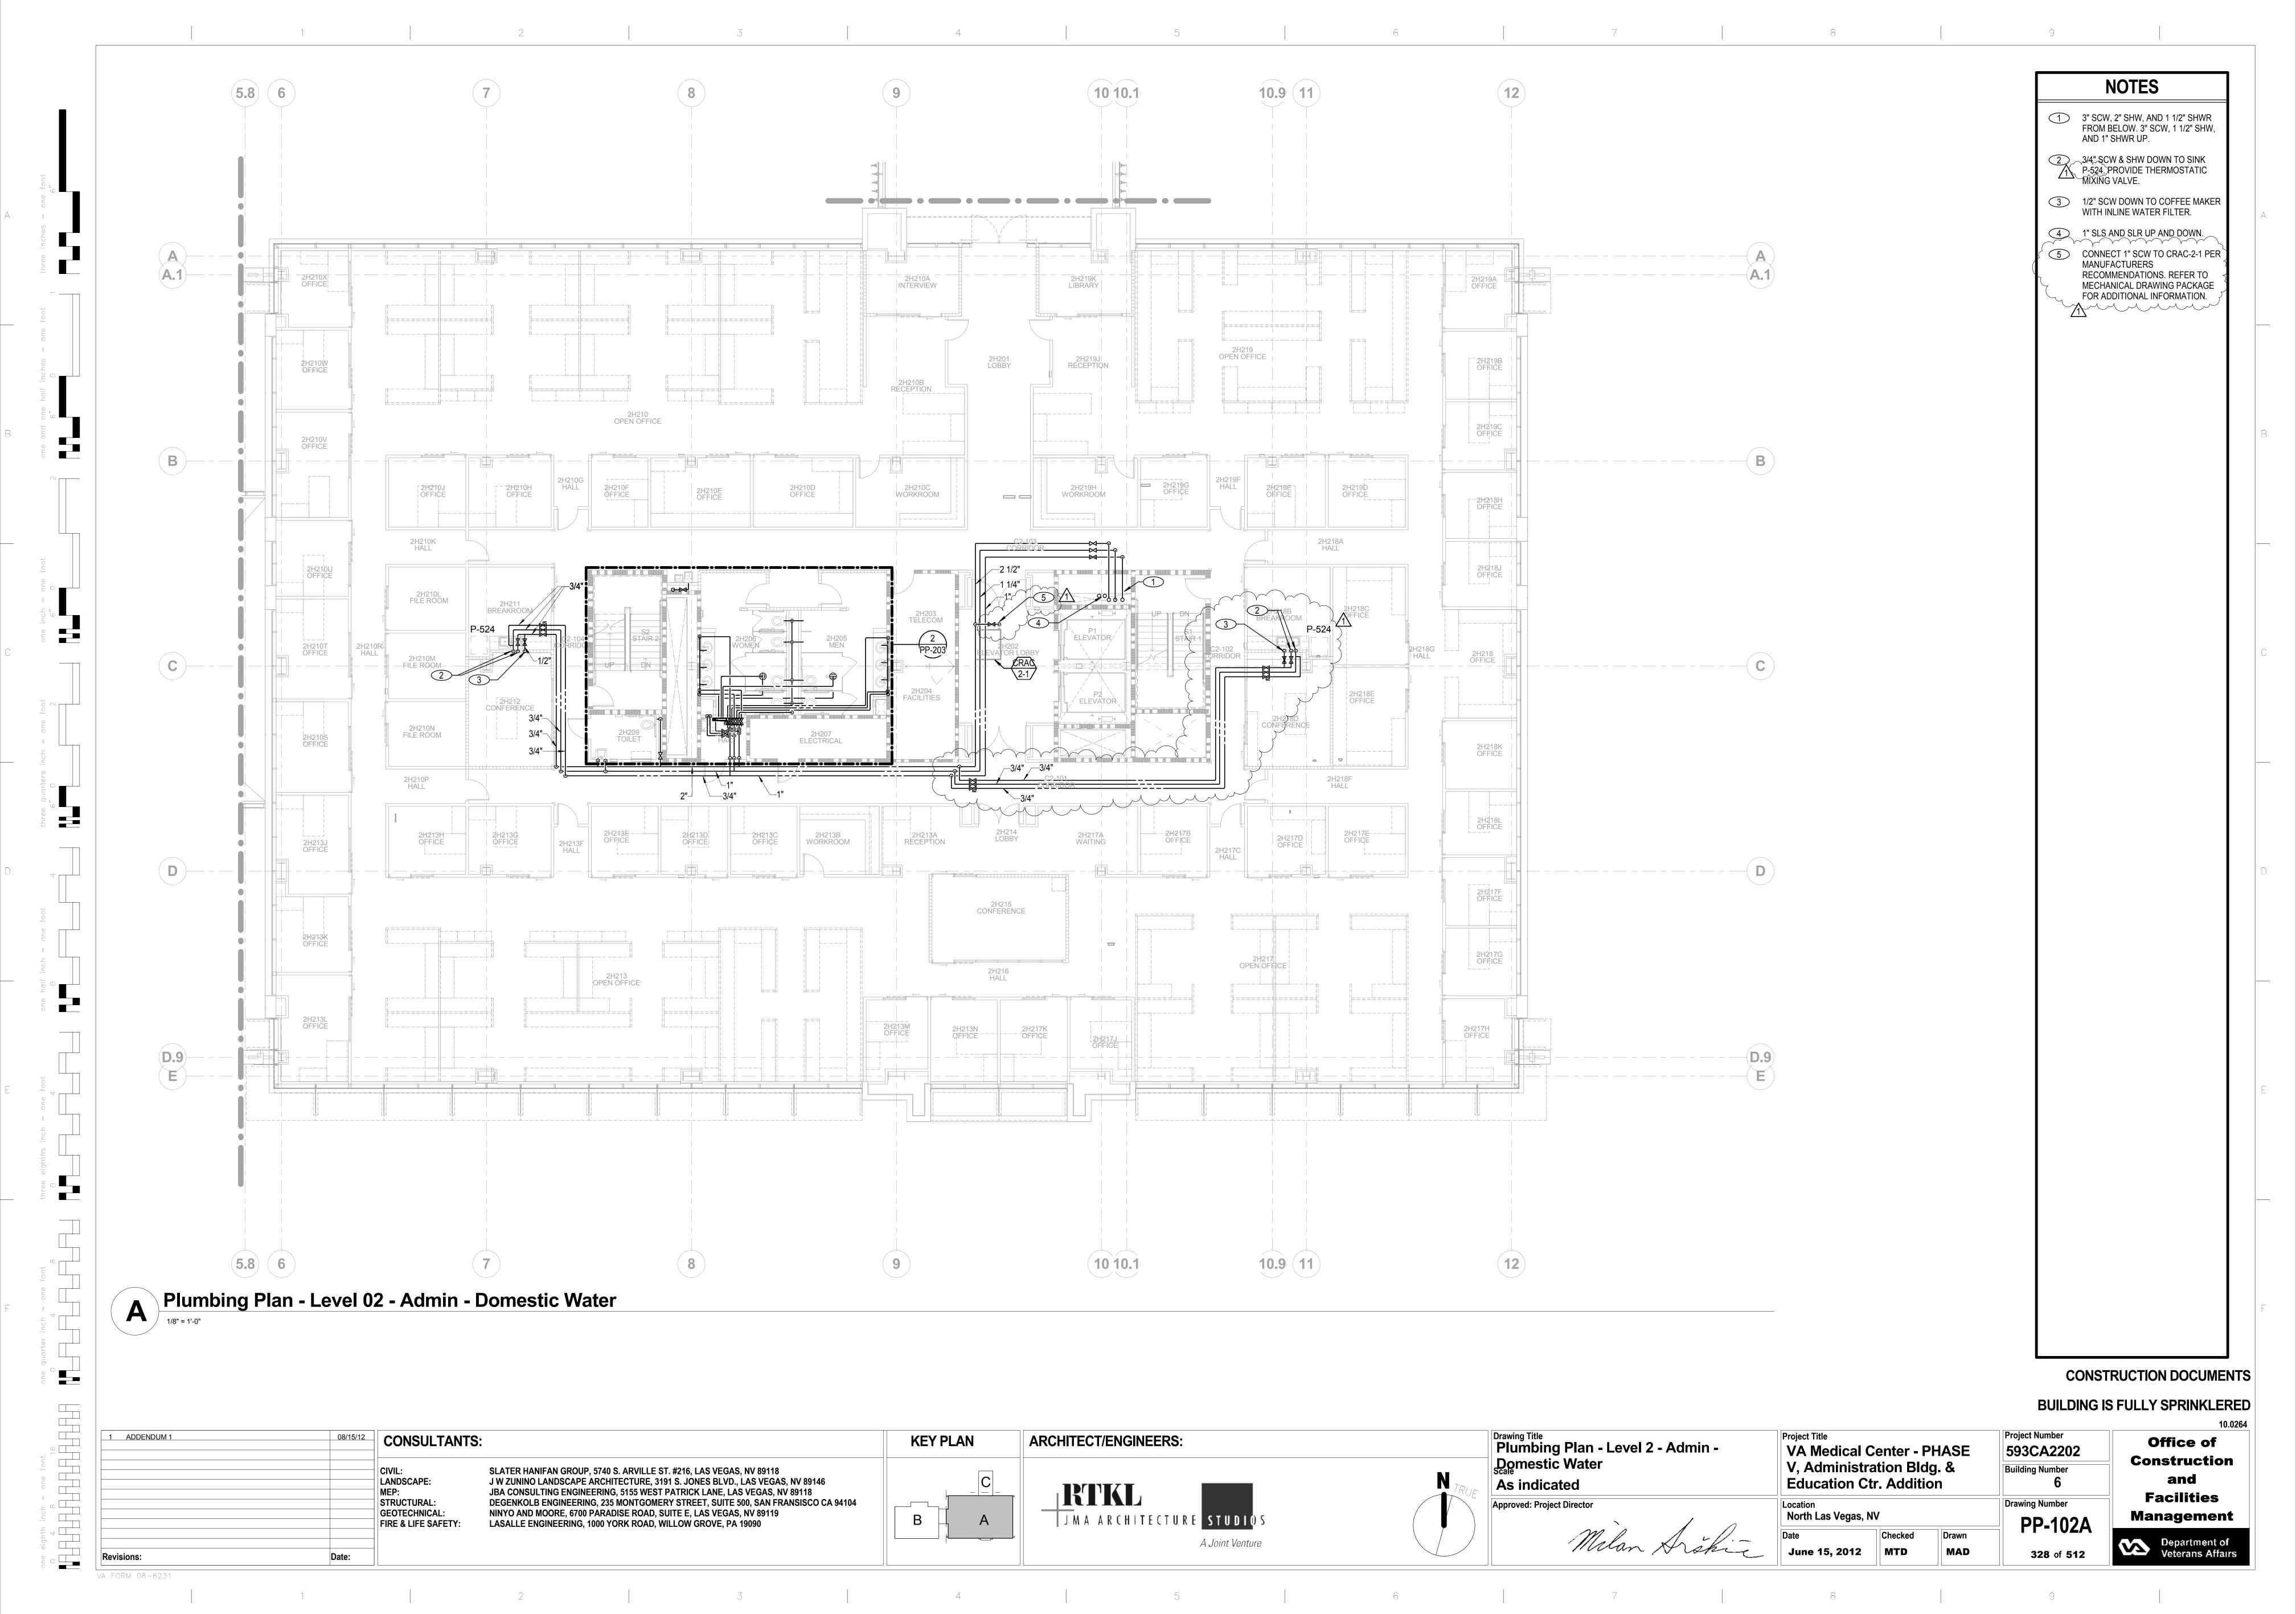


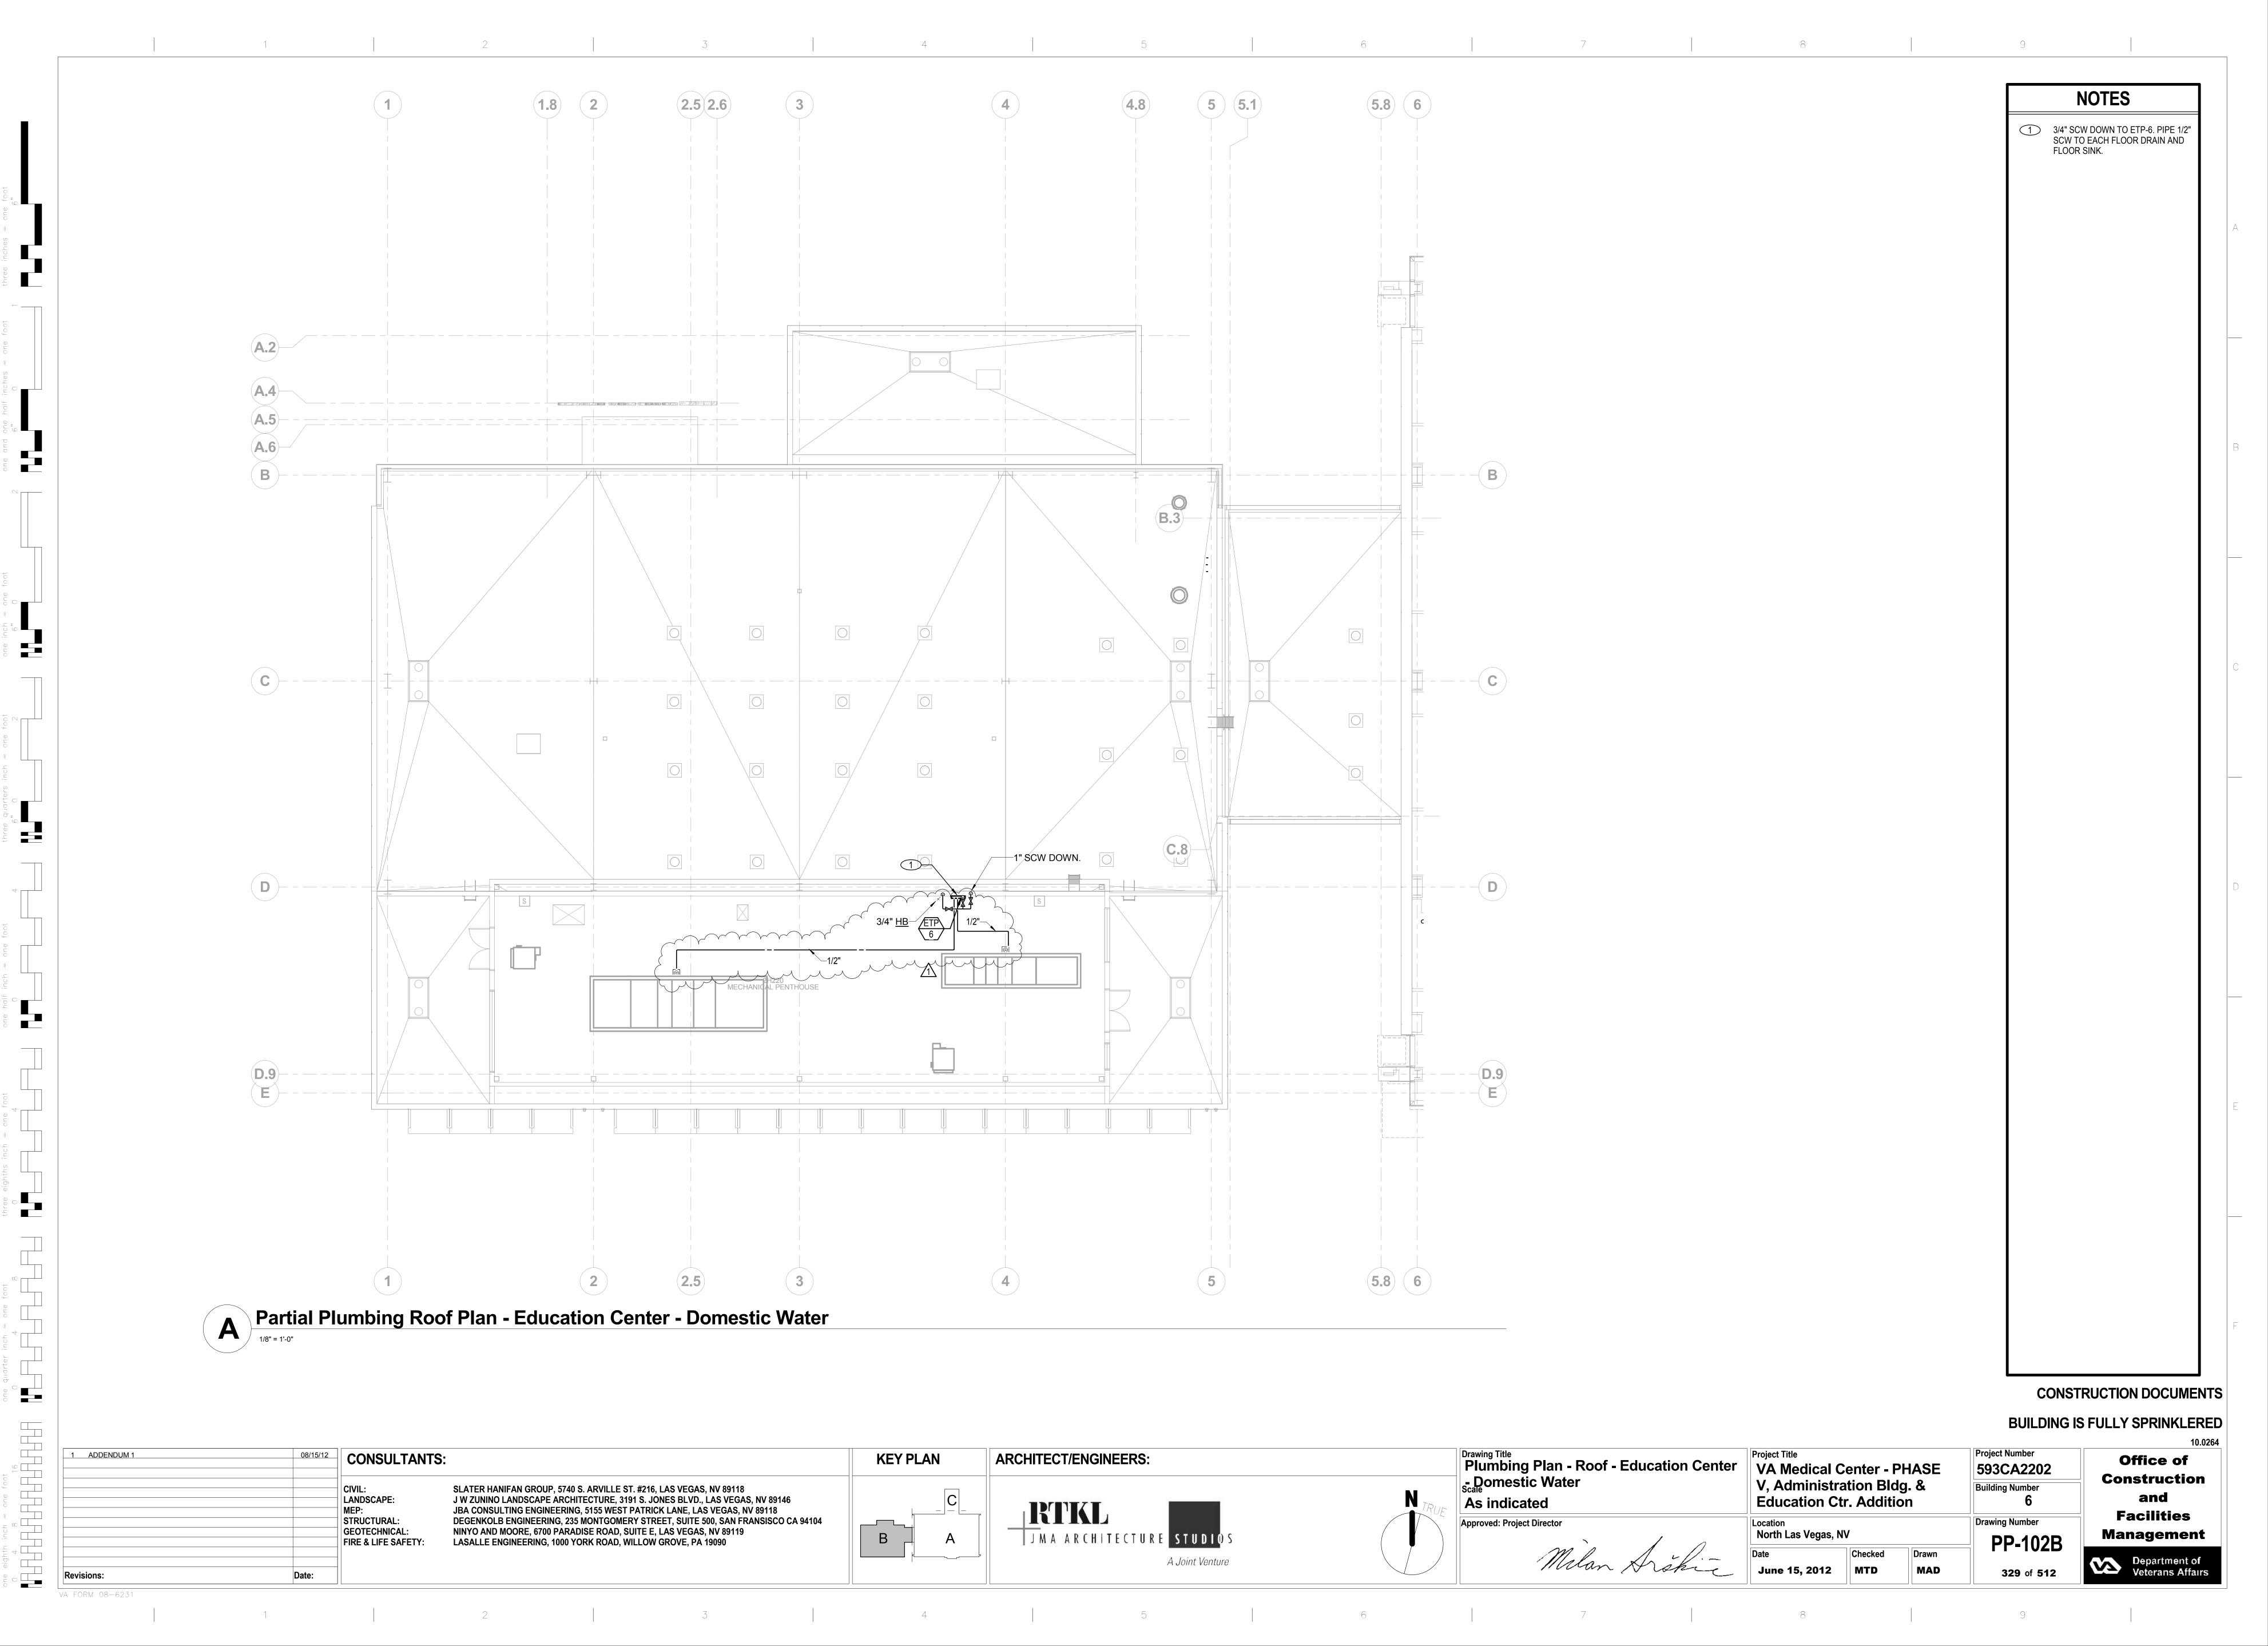


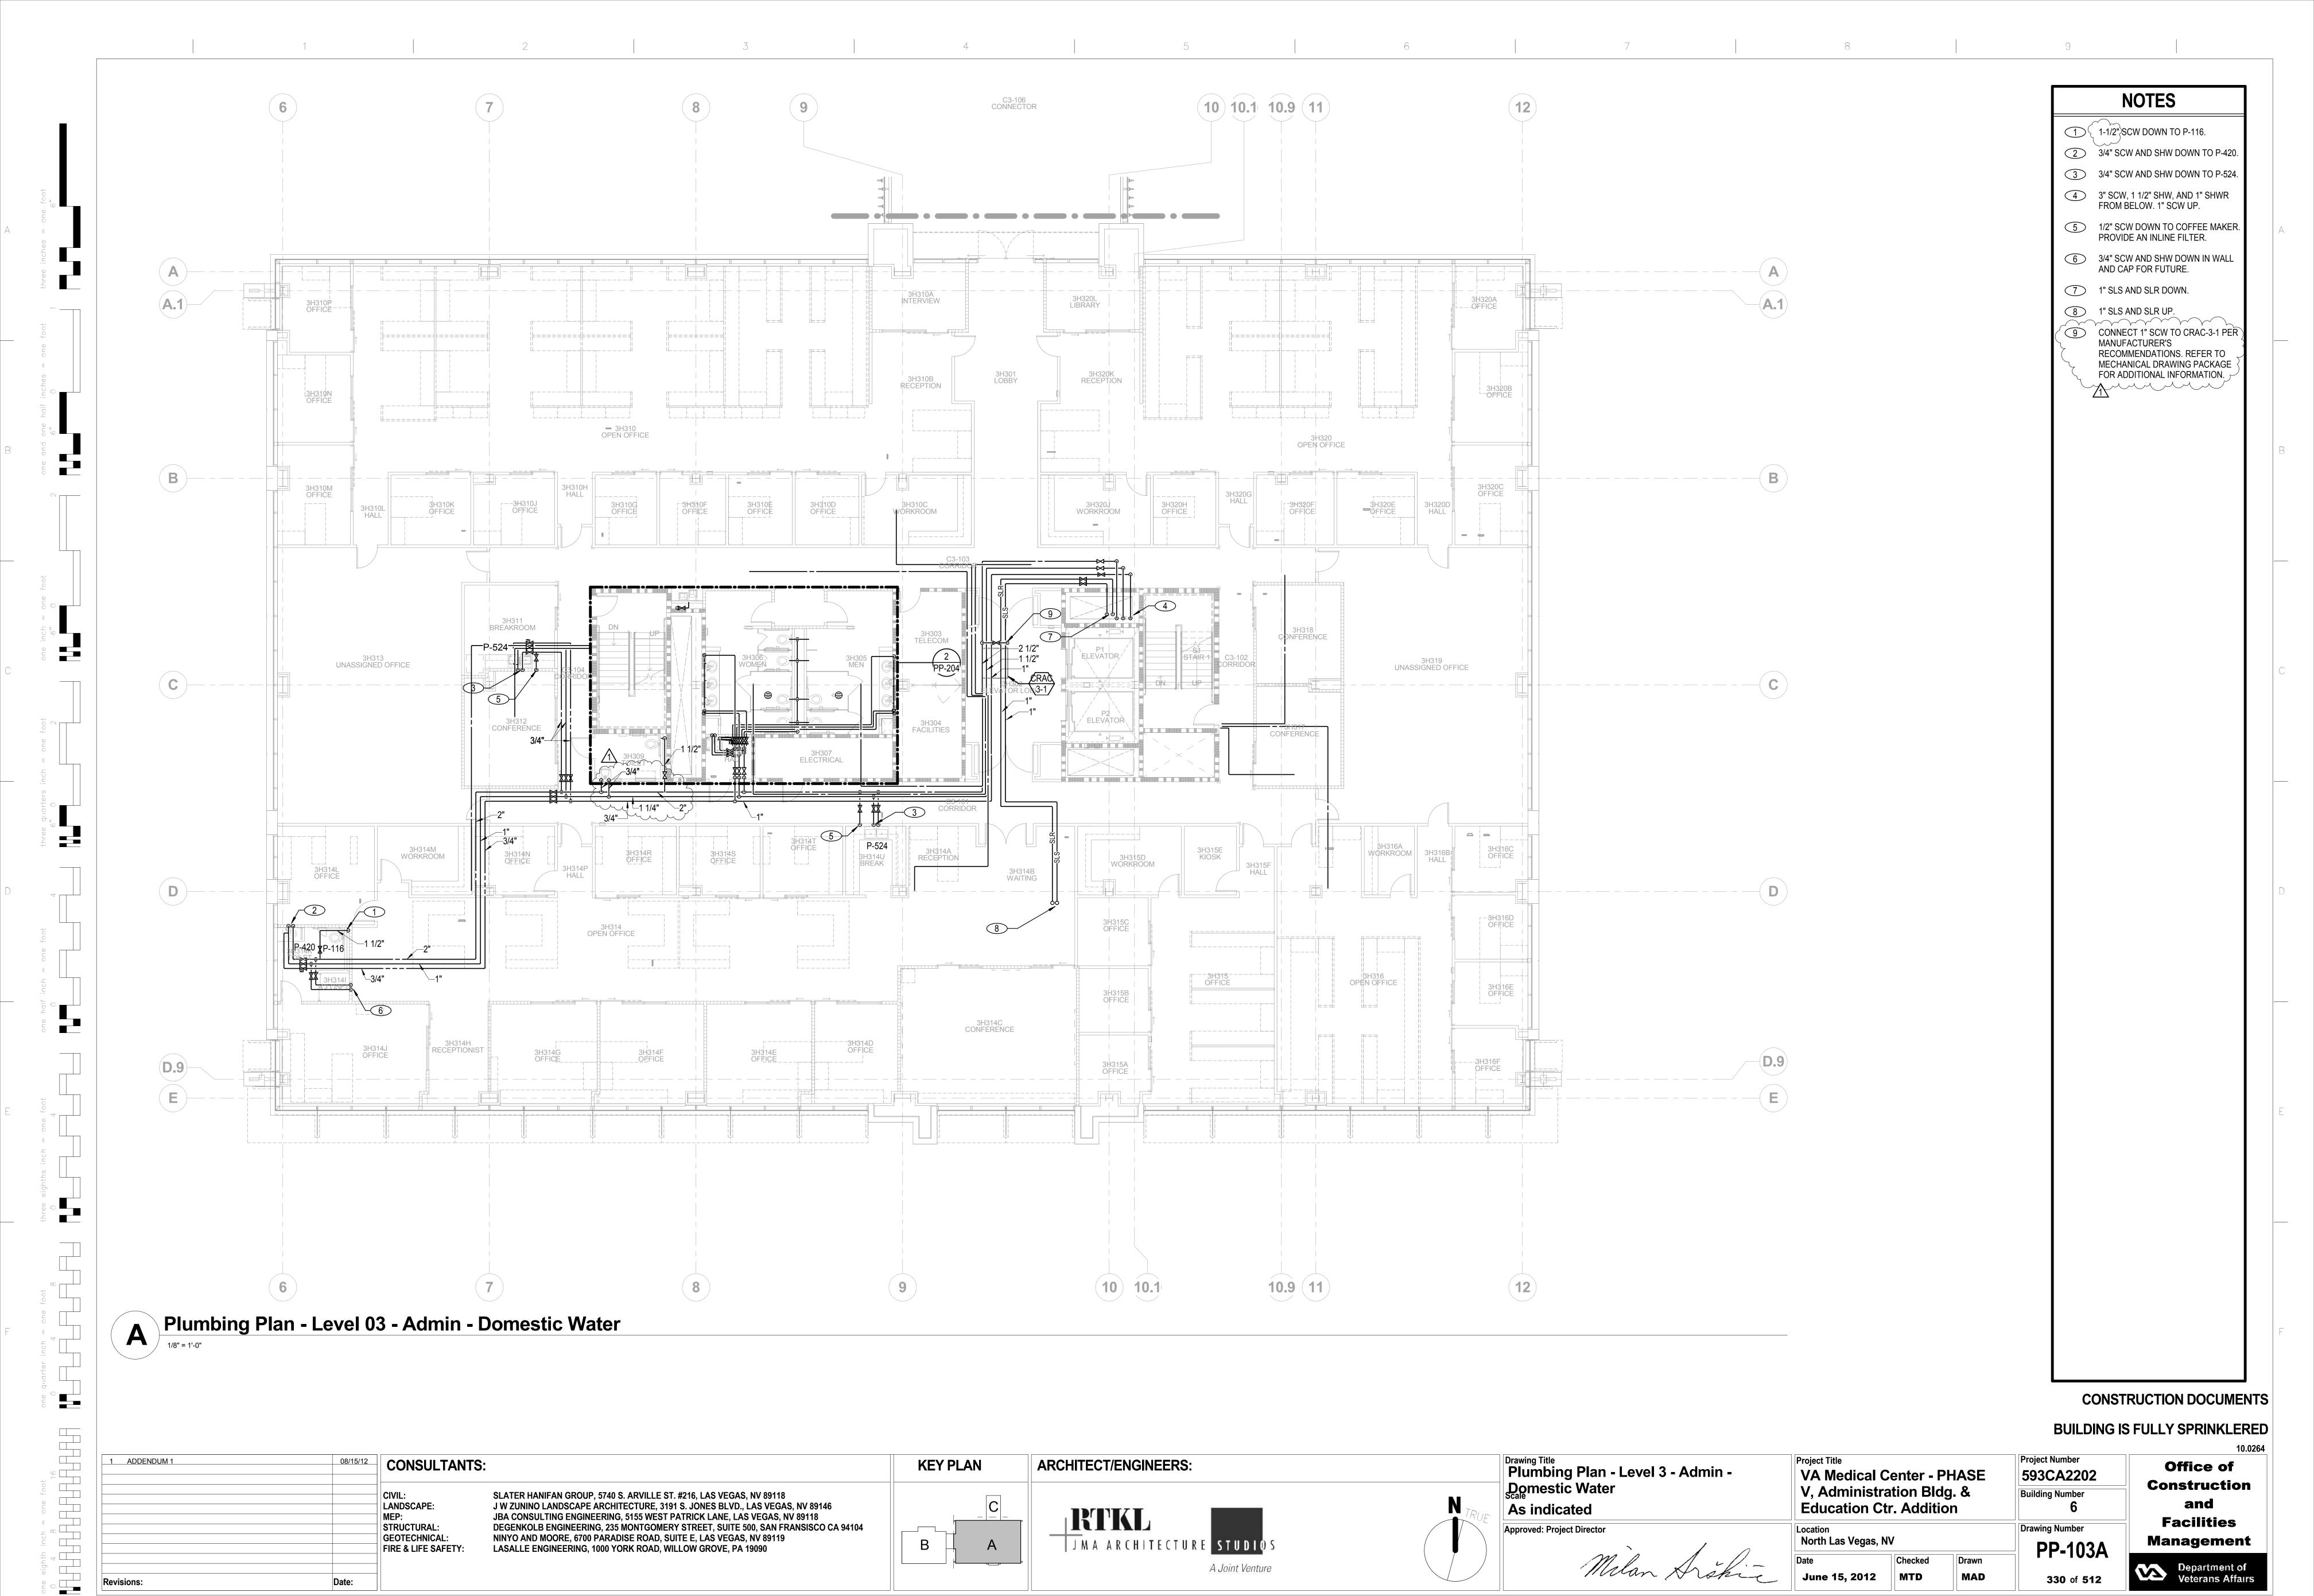

**330** of **512** 

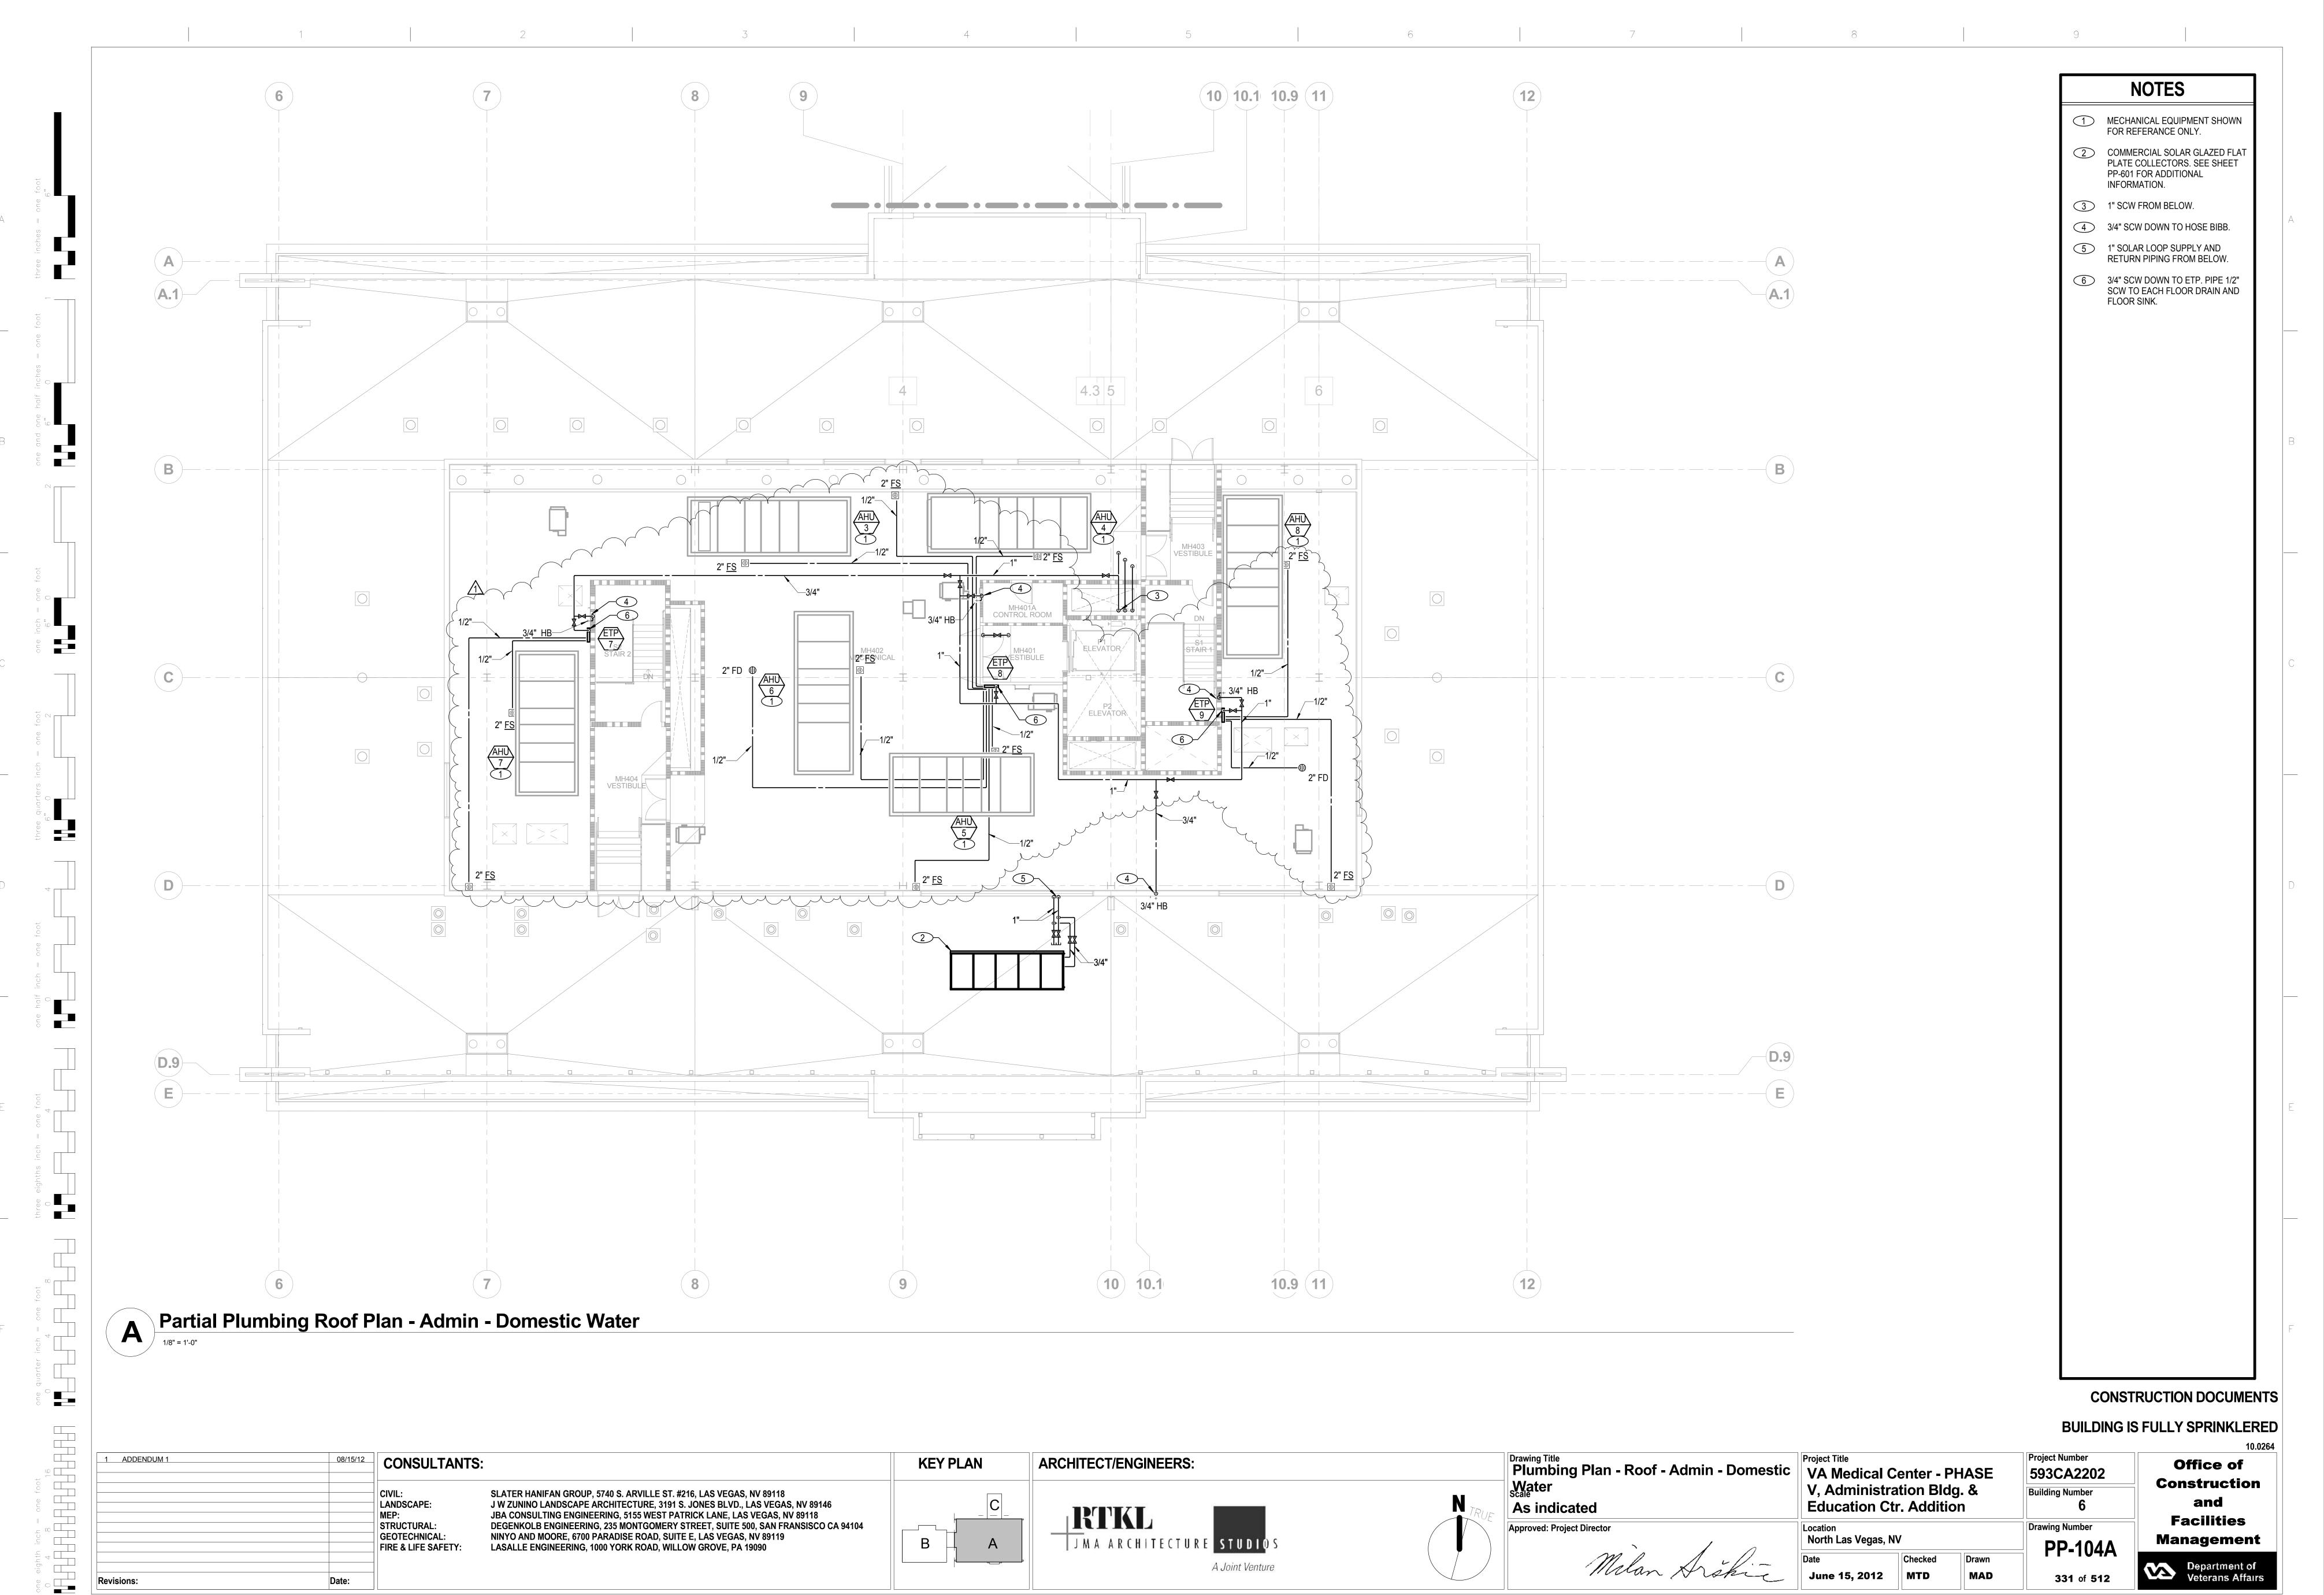

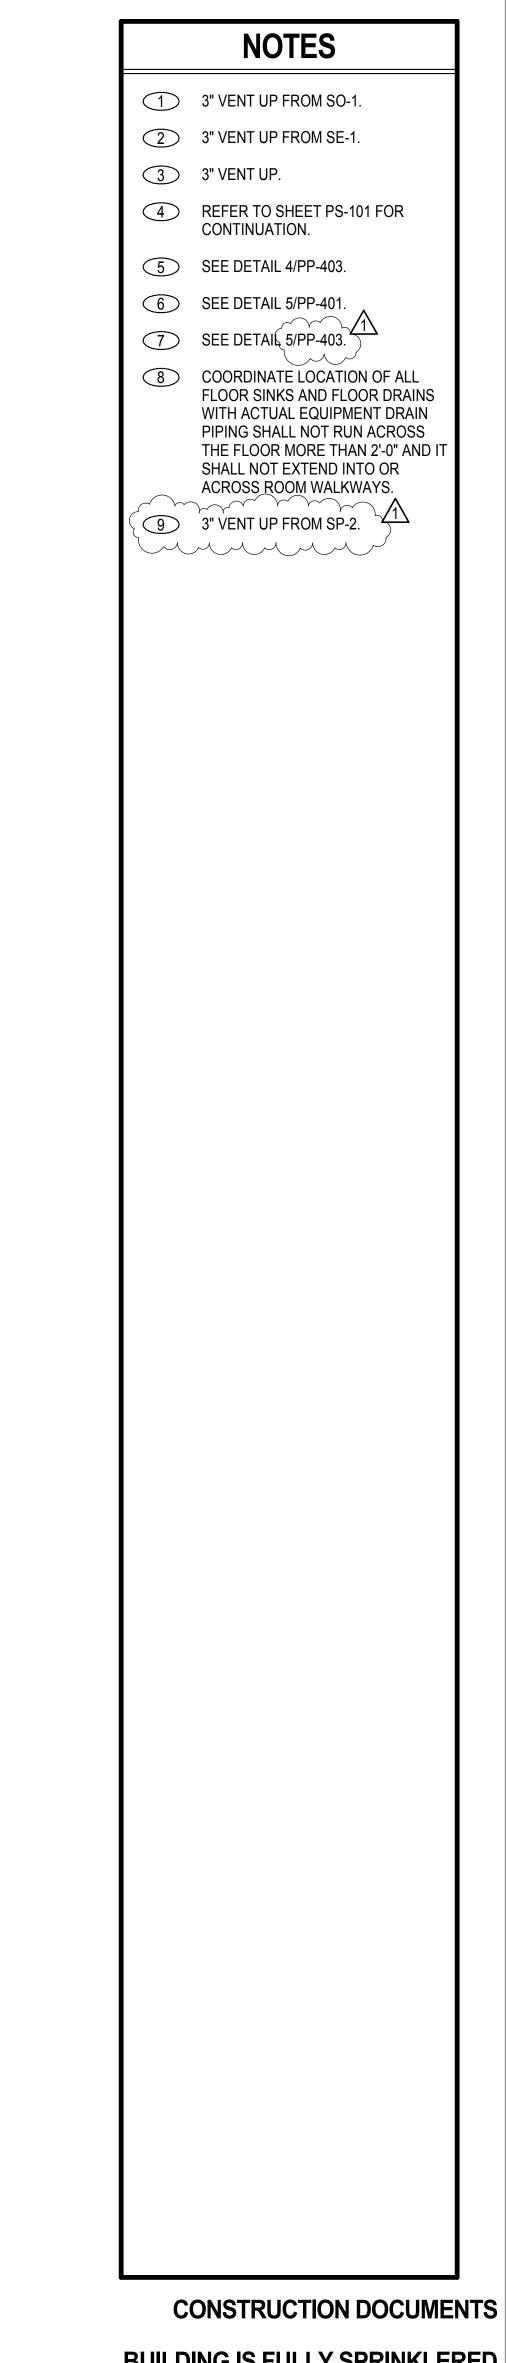


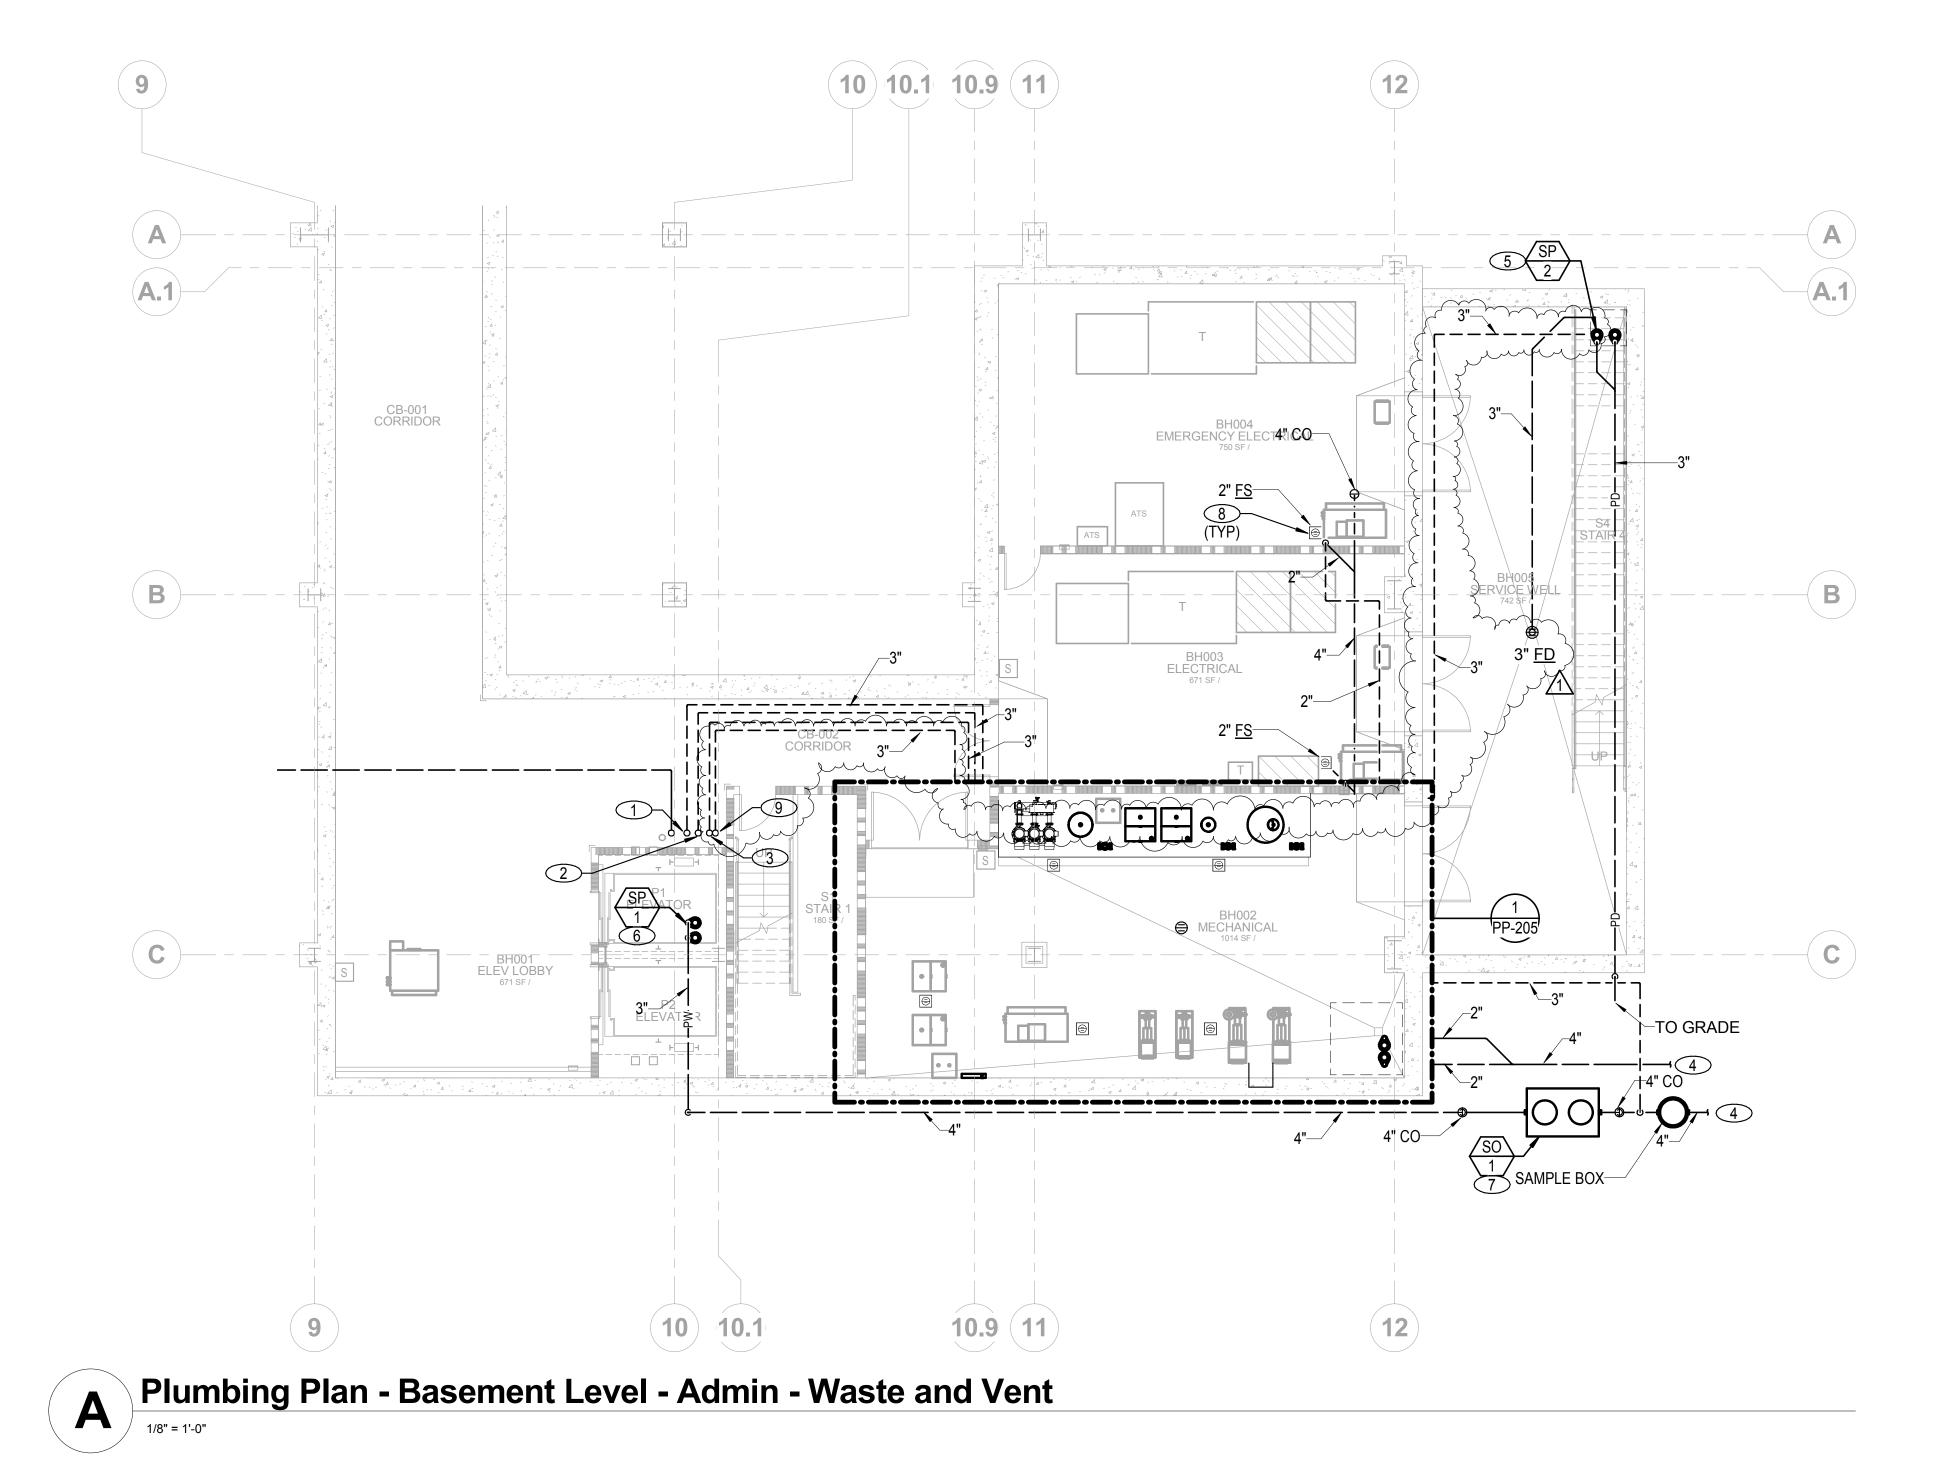


**BUILDING IS FULLY SPRINKLERED** 

1 ADDENDUM 1	08/15/12 CONSULTAN	NTS:	KEY PLAN	ARCHITECT/ENGINEERS:		Plumbing Plan - Basement Level - Admin	Project Title  VA Medical Center - PHASE	Project Number 593CA2202	Office of
	CIVIL:	SLATER HANIFAN GROUP, 5740 S. ARVILLE ST. #216, LAS VEGAS, NV 89118			NI	- Waste and Vent	V, Administration Bldg. &	Building Number	Construction
	LANDSCAPE: MEP:	J W ZUNINO LANDSCAPE ARCHITECTURE, 3191 S. JONES BLVD., LAS VEGAS, NV 89146 JBA CONSULTING ENGINEERING, 5155 WEST PATRICK LANE, LAS VEGAS, NV 89118 DEGENKOLB ENGINEERING, 235 MONTGOMERY STREET, SUITE 500, SAN FRANSISCO CA 94104		RTKL	TRUE	As indicated	Education Ctr. Addition	6	and Facilities
	STRUCTURAL: GEOTECHNICAL: FIRE & LIFE SAFETY:	NINYO AND MOORE, 6700 PARADISE ROAD, SUITE E, LAS VEGAS, NV 89119  ': LASALLE ENGINEERING, 1000 YORK ROAD, WILLOW GROVE, PA 19090	$\begin{bmatrix} B \end{bmatrix} A$	J M A A R CHITECTURE STUDIOS		Approved: Project Director	North Las Vegas, NV	Drawing Number PL-100A	Management
				A Joint Venture		Milan Arshi-	Date Checked Drawn	I L-100A	Department of
Revisions:	Date:			A com venture		Man Arske	June 15, 2012 Checker MAD	<b>332</b> of <b>512</b>	Veterans

 2
 5

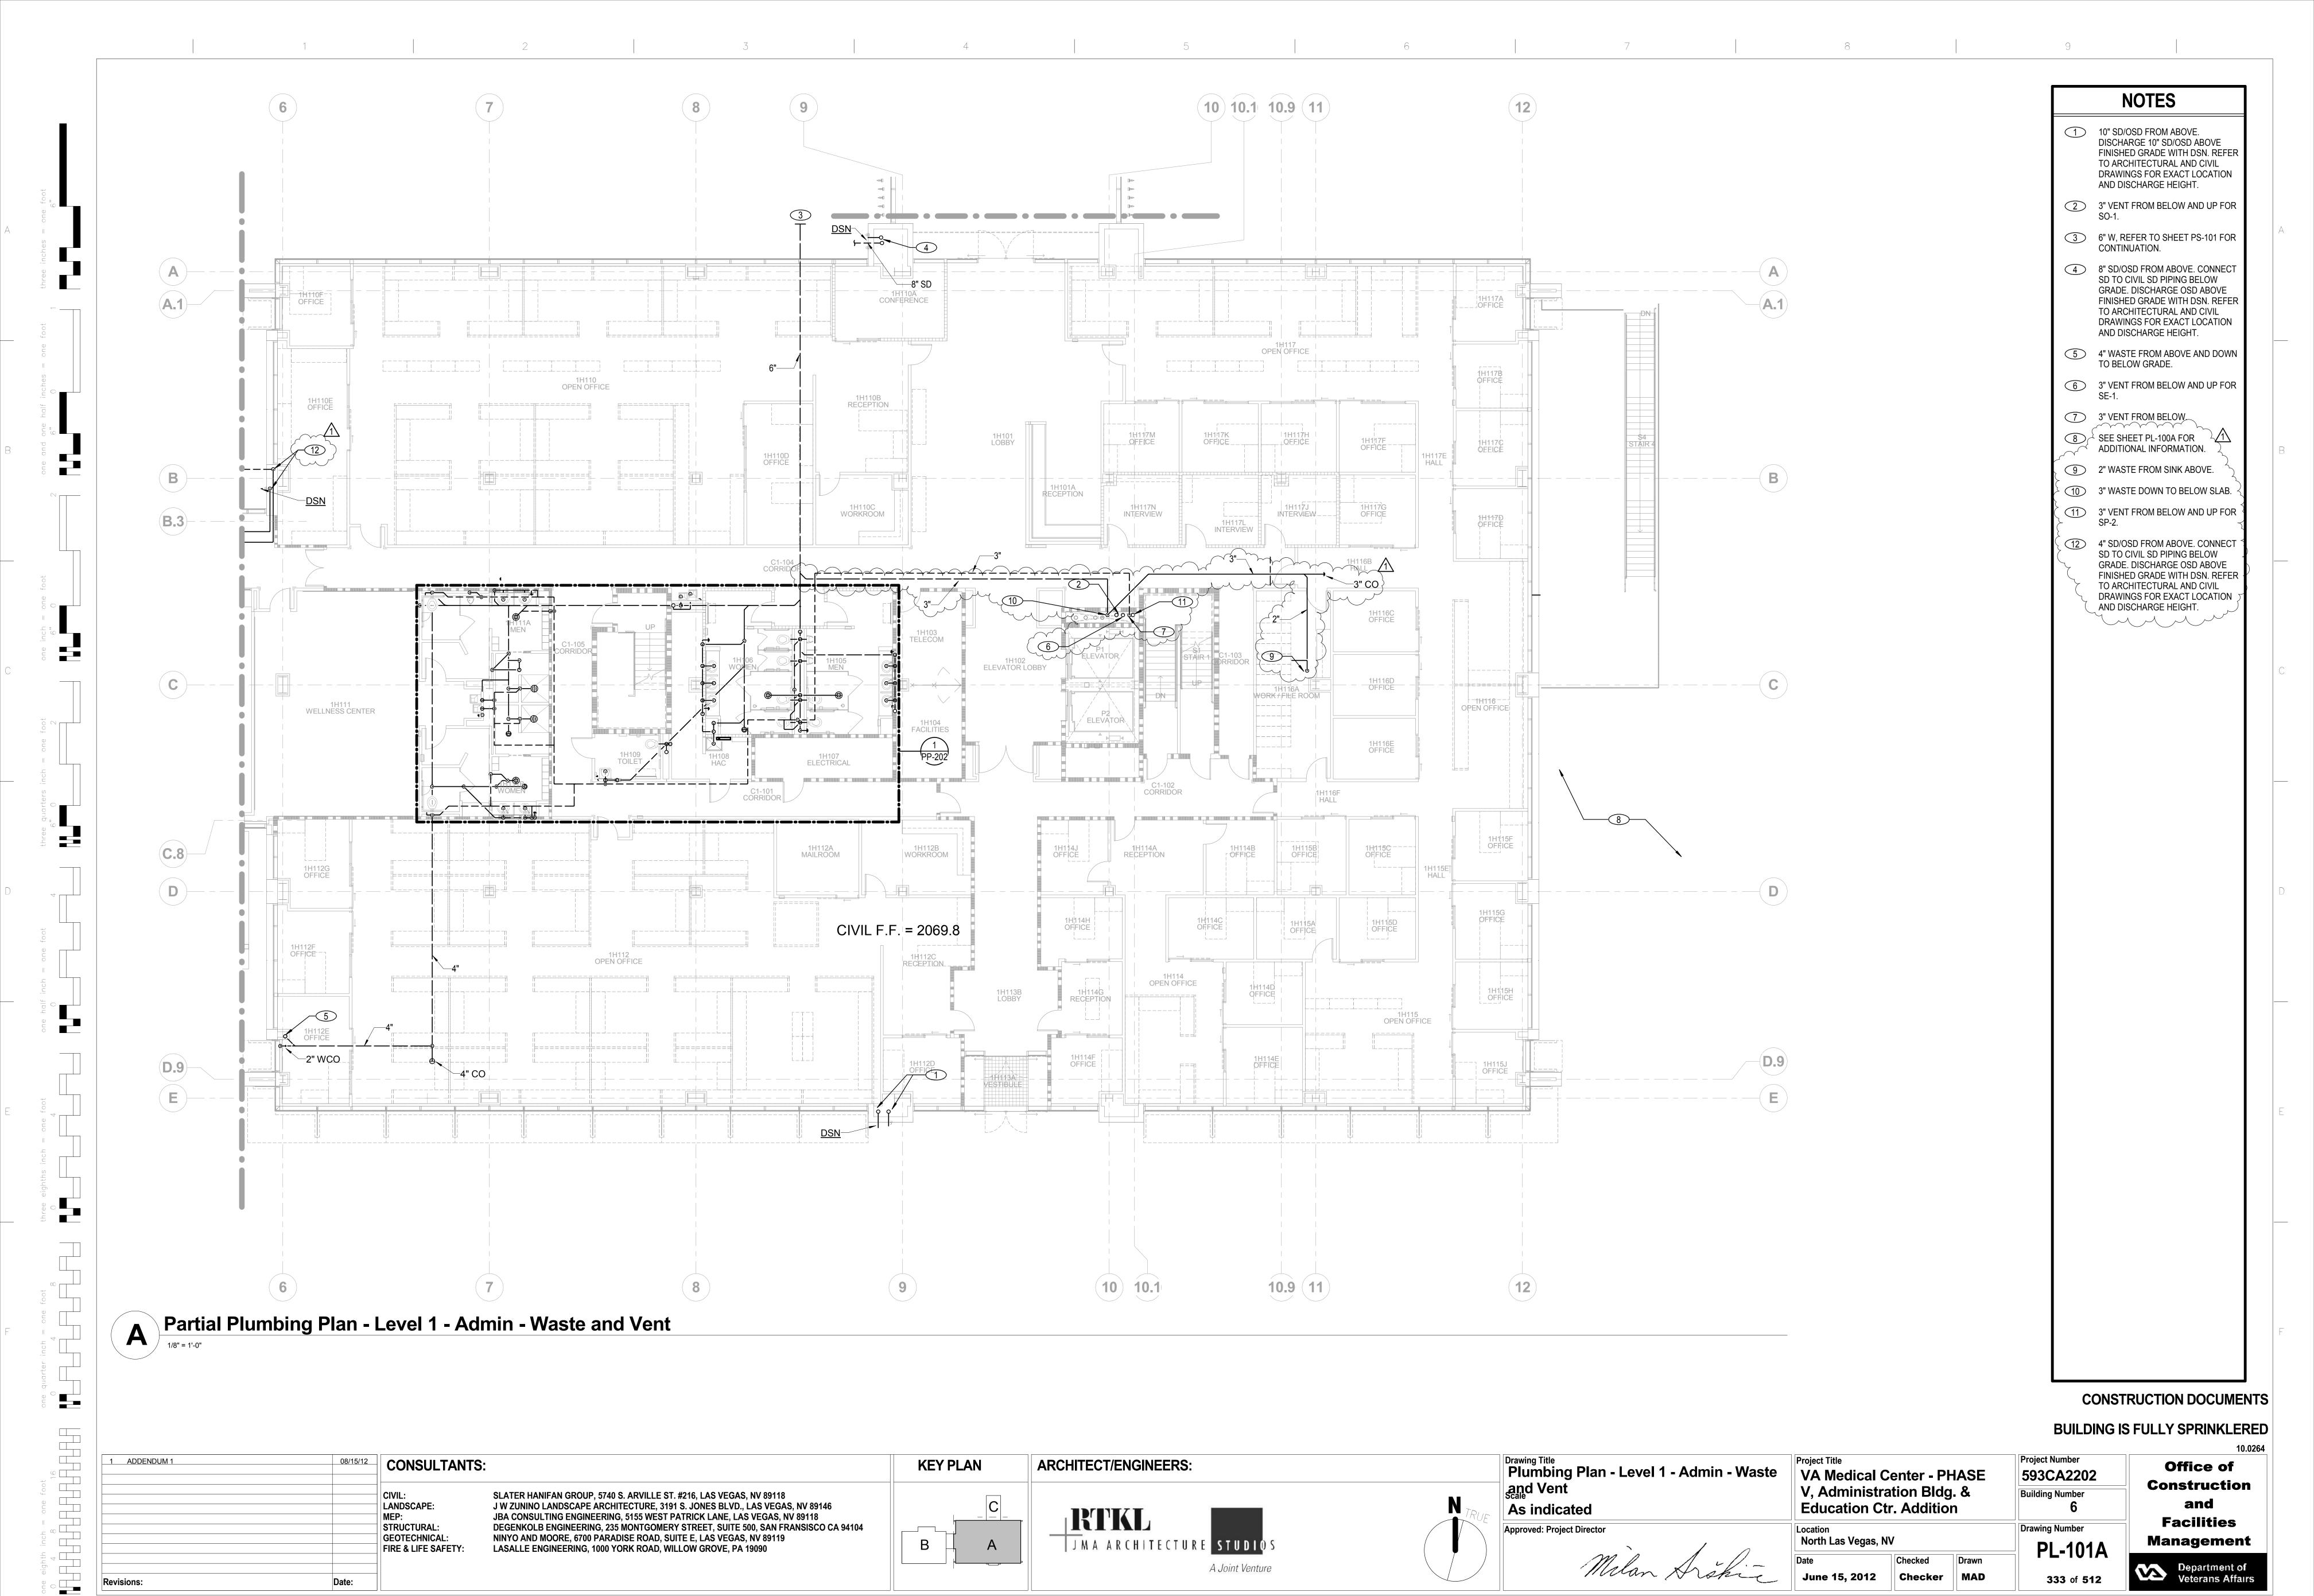


333 of 512

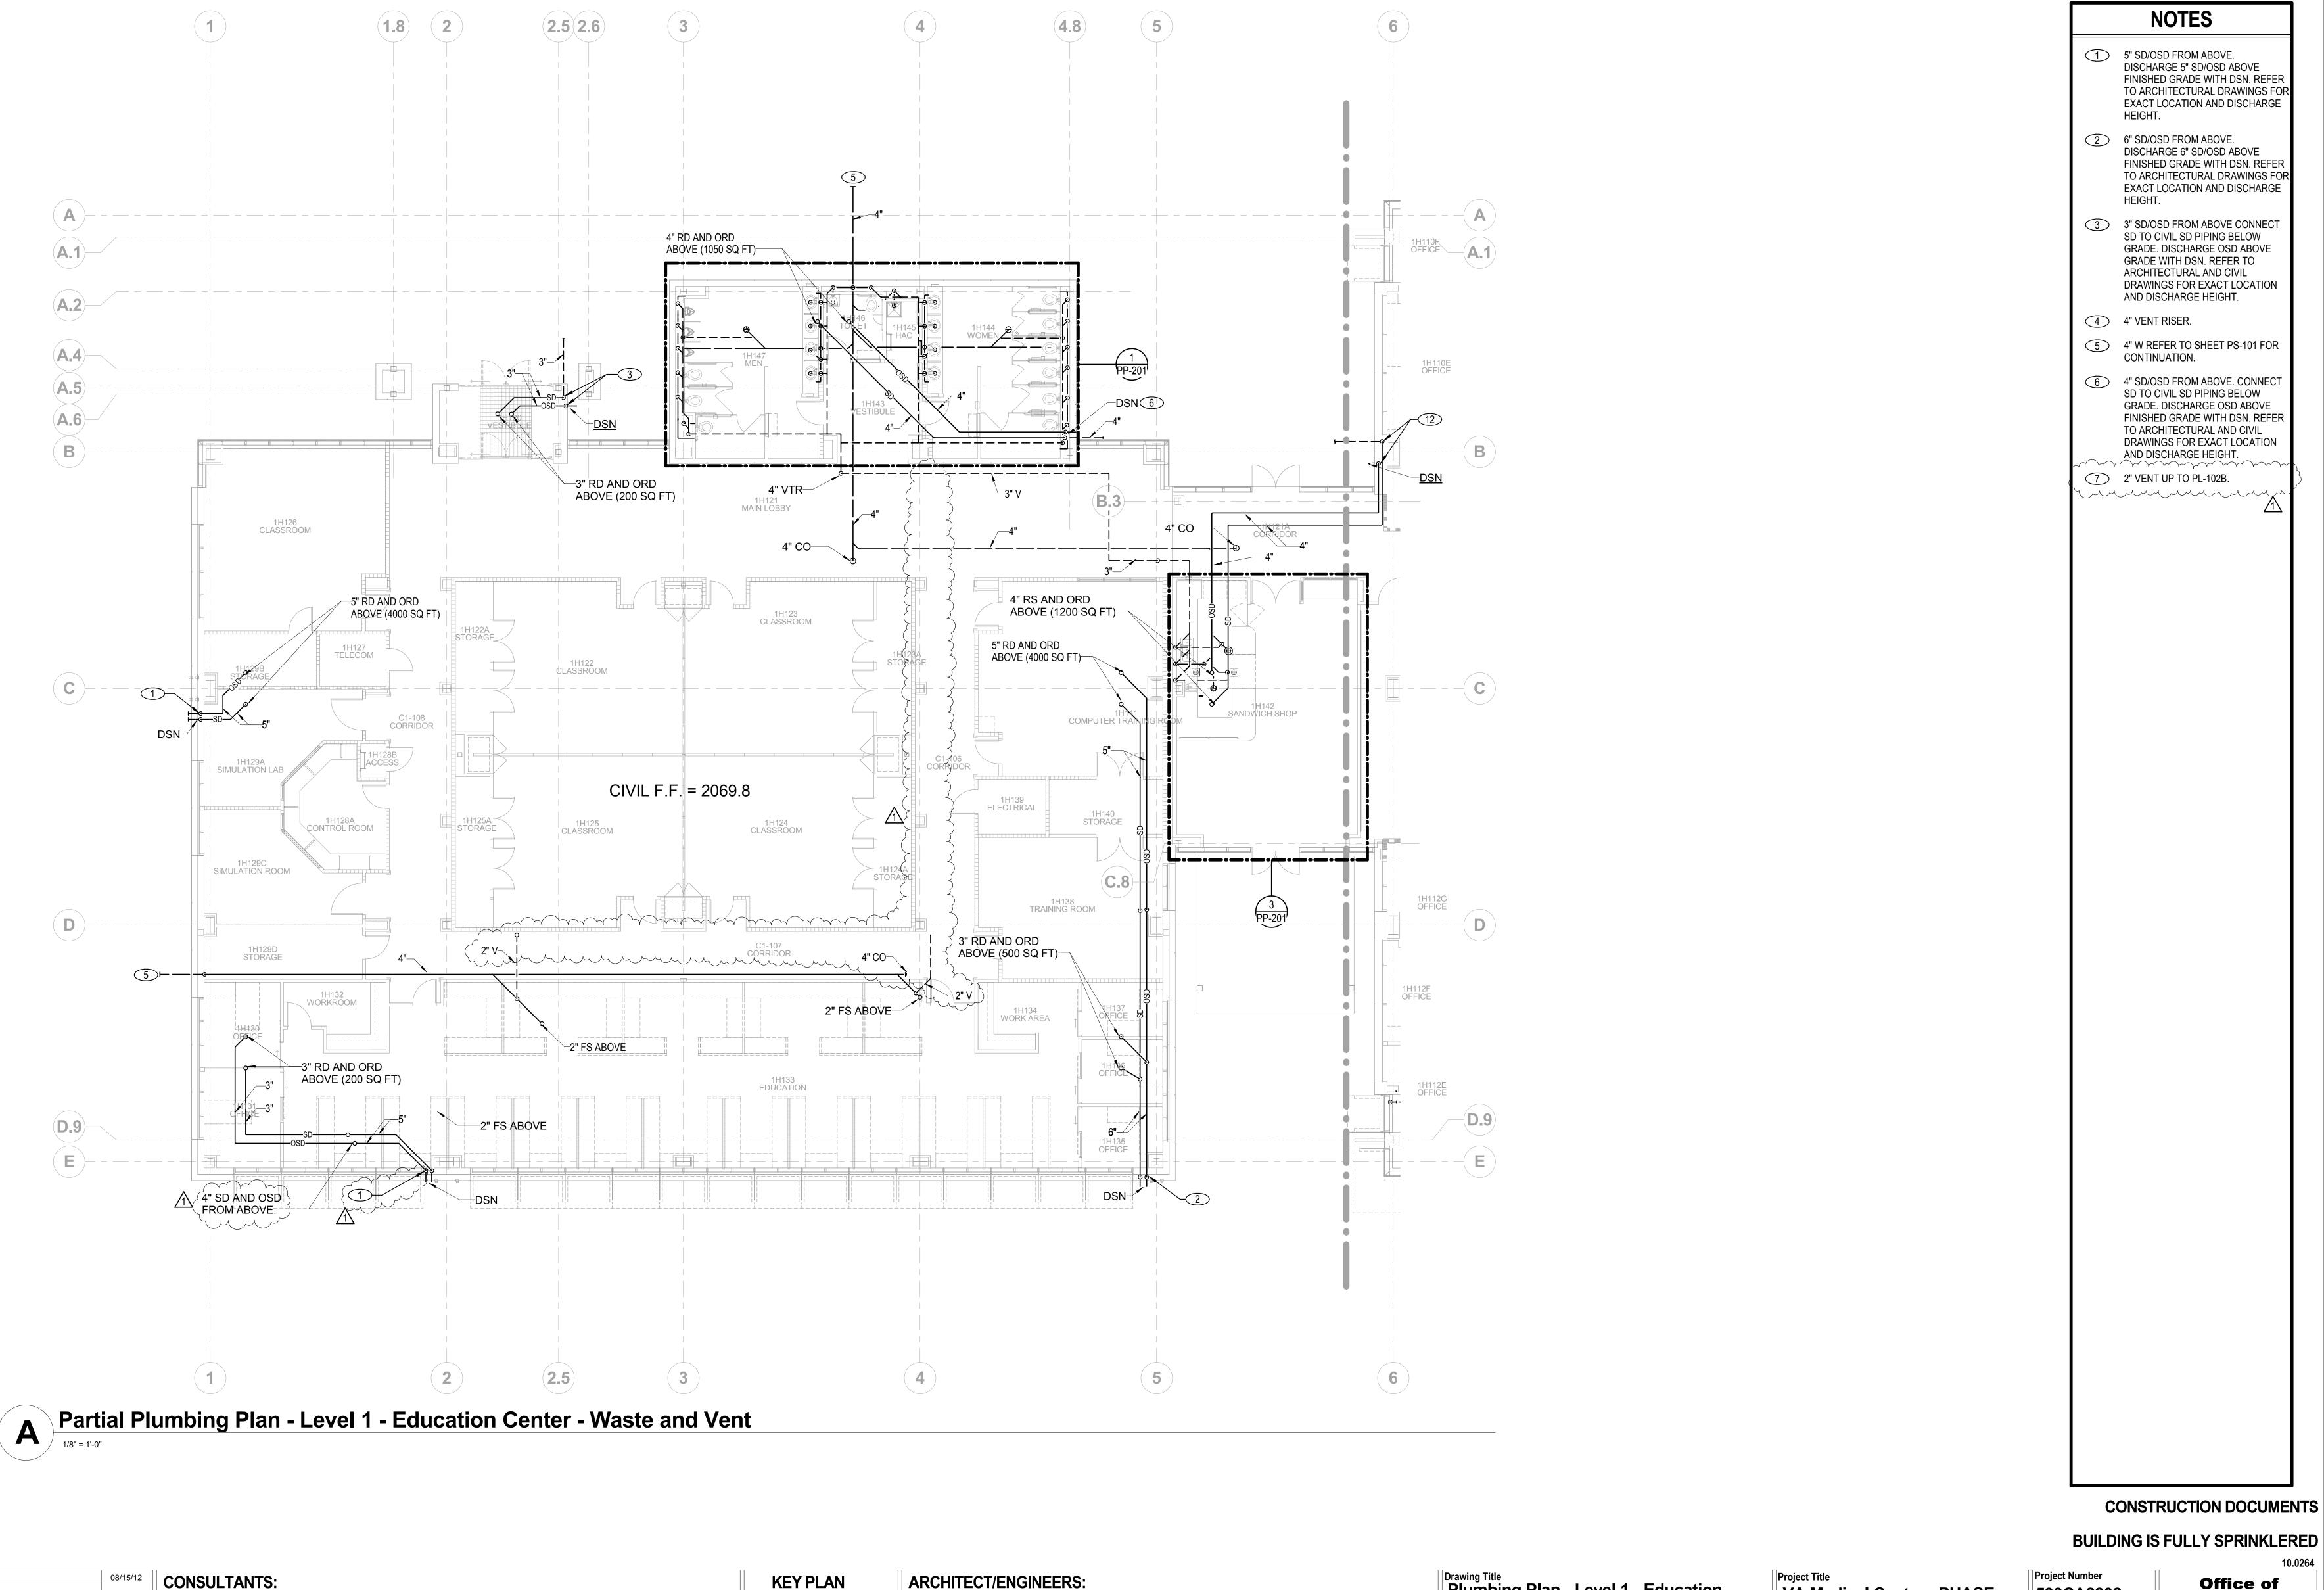



						10.0264
1 ADDENDUM 1 08/15/12 CONSULTANTS:	KEY PLAN	ARCHITECT/ENGINEERS:	Plumbing Plan - Level 1 - Education	Project Title	Project Number	Office of
			Center - Waste and Vent	VA Medical Center - PHASE	593CA2202	Construction
CIVIL: SLATER HANIFAN GROUP, 5740 S. ARVII LANDSCAPE: J W ZUNINO LANDSCAPE ARCHITECTUR	LE ST. #216, LAS VEGAS, NV 89118 E, 3191 S. JONES BLVD., LAS VEGAS, NV 89146	N	Scale	V, Administration Bldg. & Education Ctr. Addition	Building Number	and
MEP: JBA CONSULTING ENGINEERING, 5155 V	VEST PATRICK LANE, LAS VEGAS, NV 89118 OMERY STREET. SUITE 500. SAN FRANSISCO CA 94104	TRUE	As indicated	Luucation on Addition	Dunaudia a Nameh an	Facilities
GEOTECHNICAL: NINYO AND MOORE, 6700 PARADISE RO	AD, SUITE E, LAS VEGAS, NV 89119		Approved: Project Director	North Las Vegas, NV	Drawing Number	Management
FIRE & LIFE SAFETY: LASALLE ENGINEERING, 1000 YORK RO	AD, WILLOW GROVE, PA 19090	J M A A R C H I T E C T U R E S T U D I O S	min 1.0	Date Checked Drawn	PL-101B	
		A Joint Venture	Milan Arskin	June 15, 2012 Checker MAD	334 of 512	Department of
Revisions: Date:					334 01 512	Veteralis Alialis


 1
 5


 3
 9

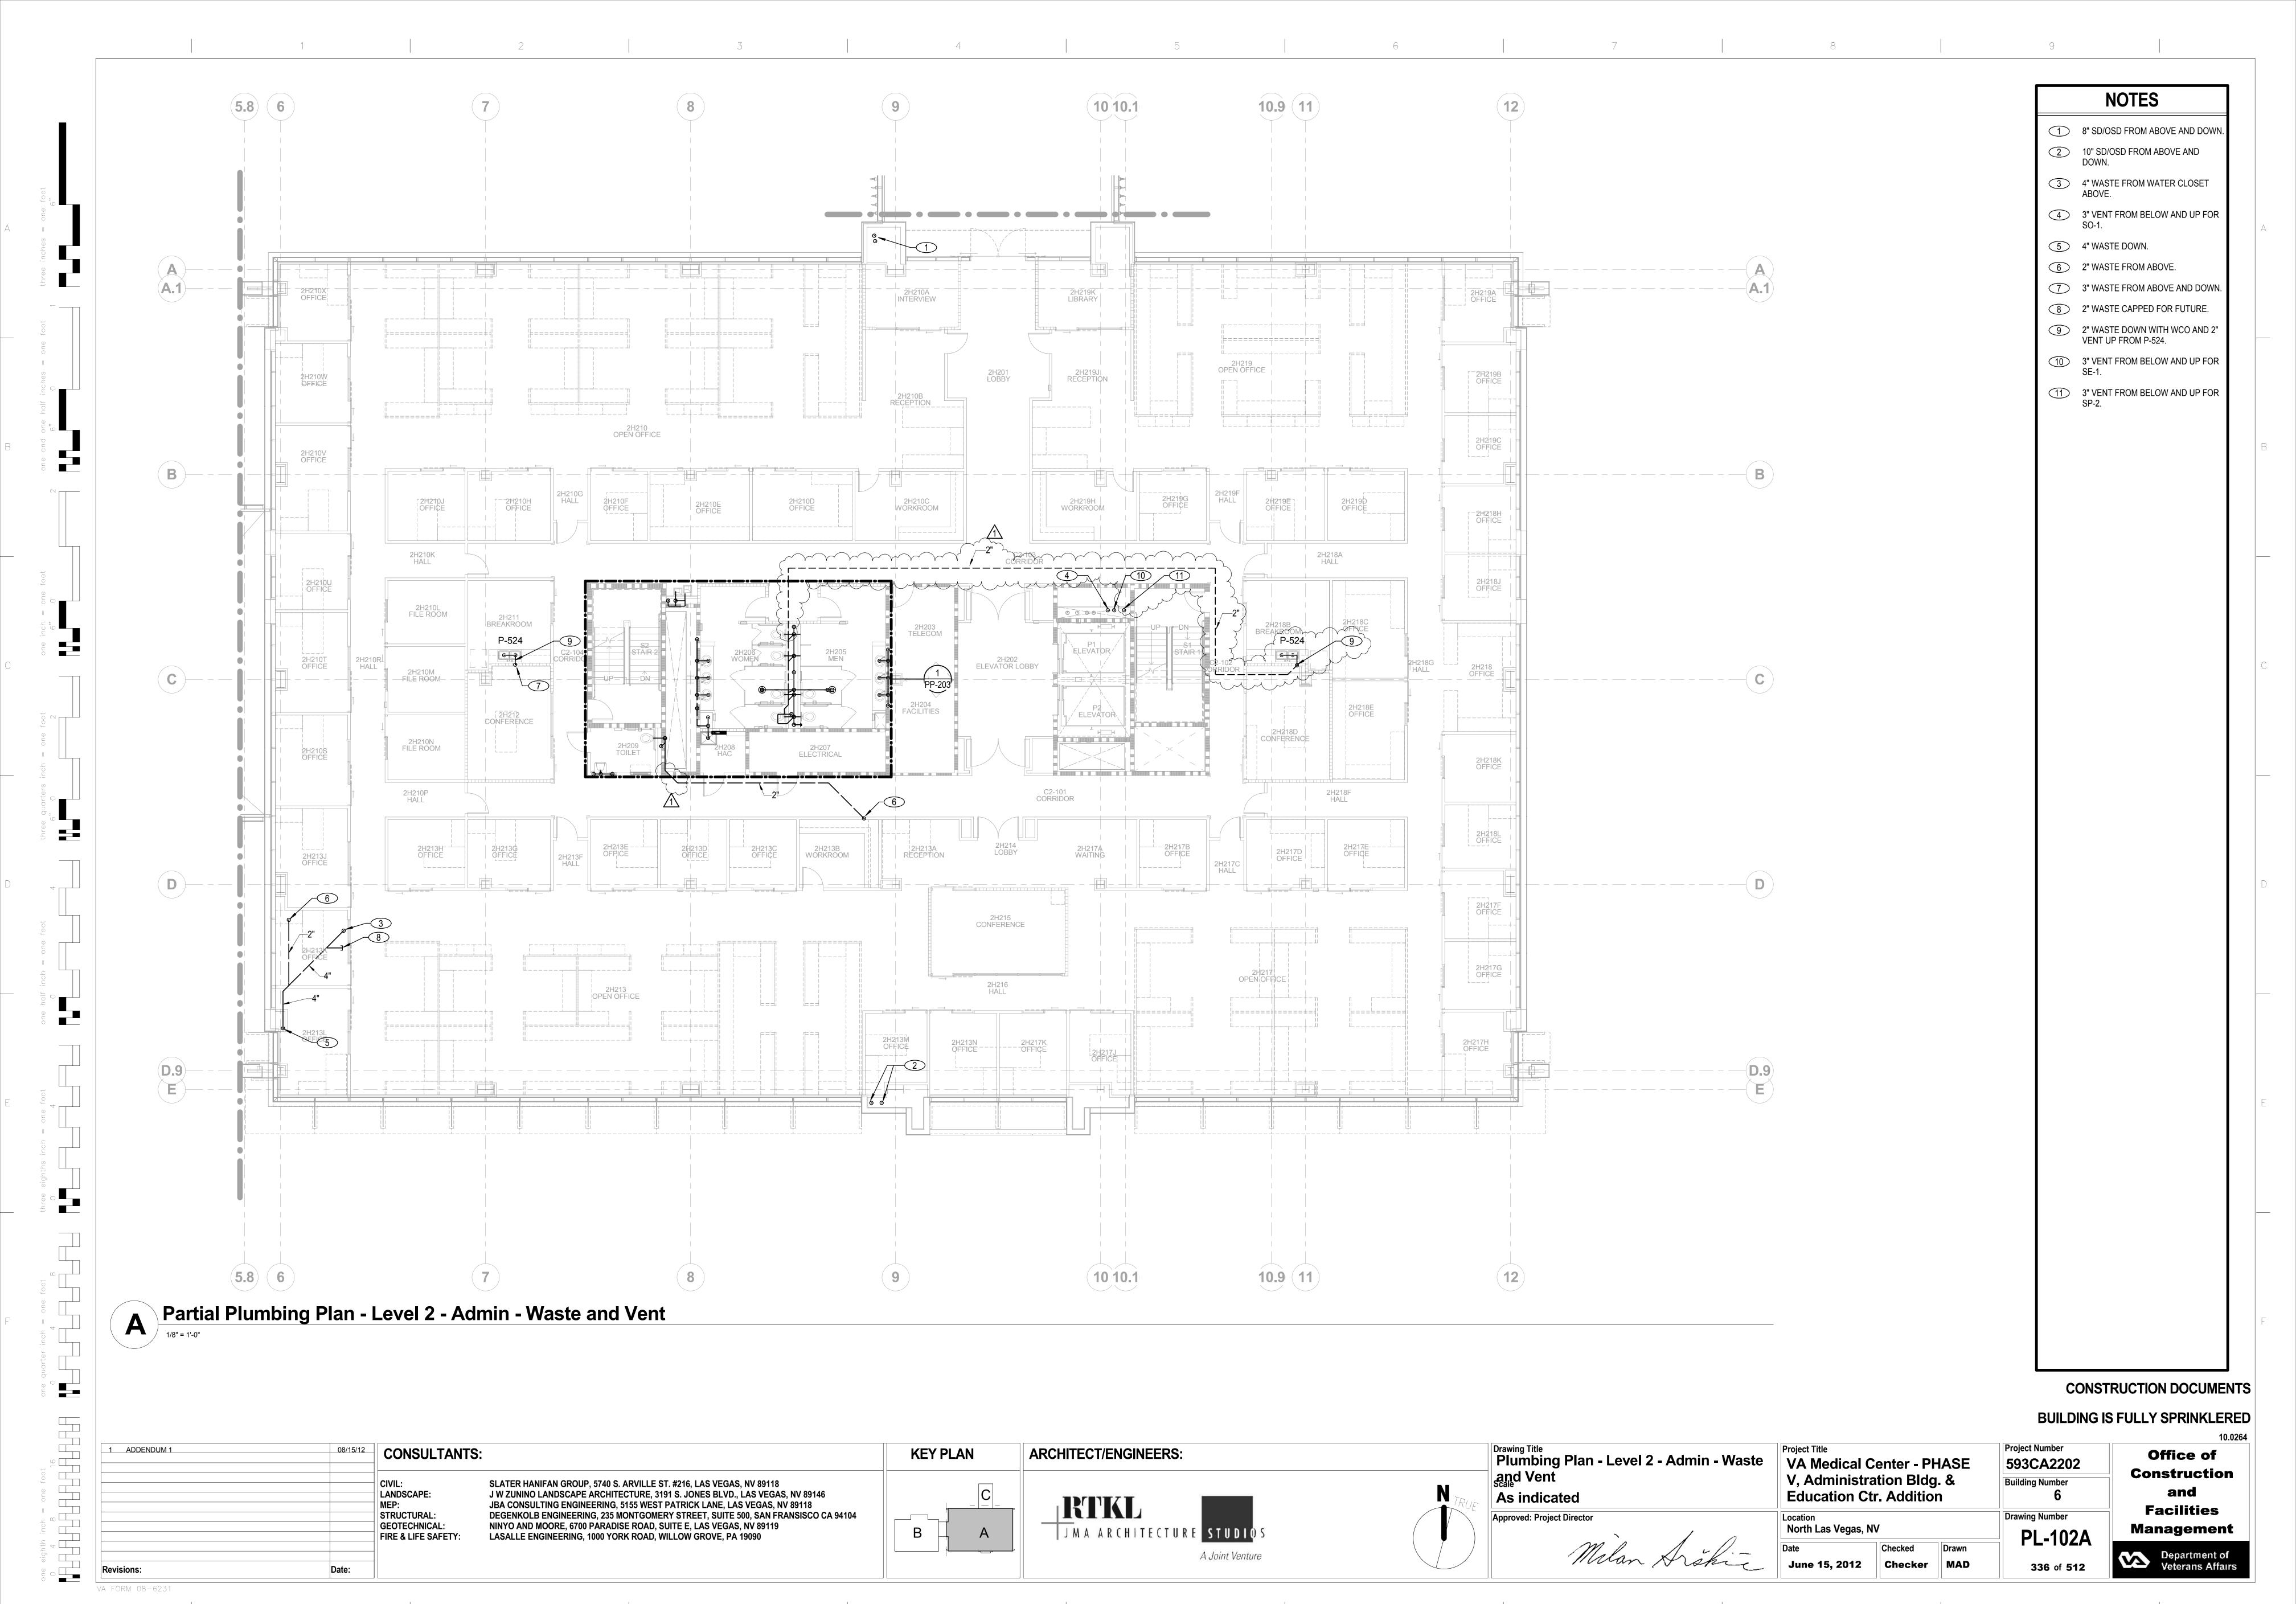


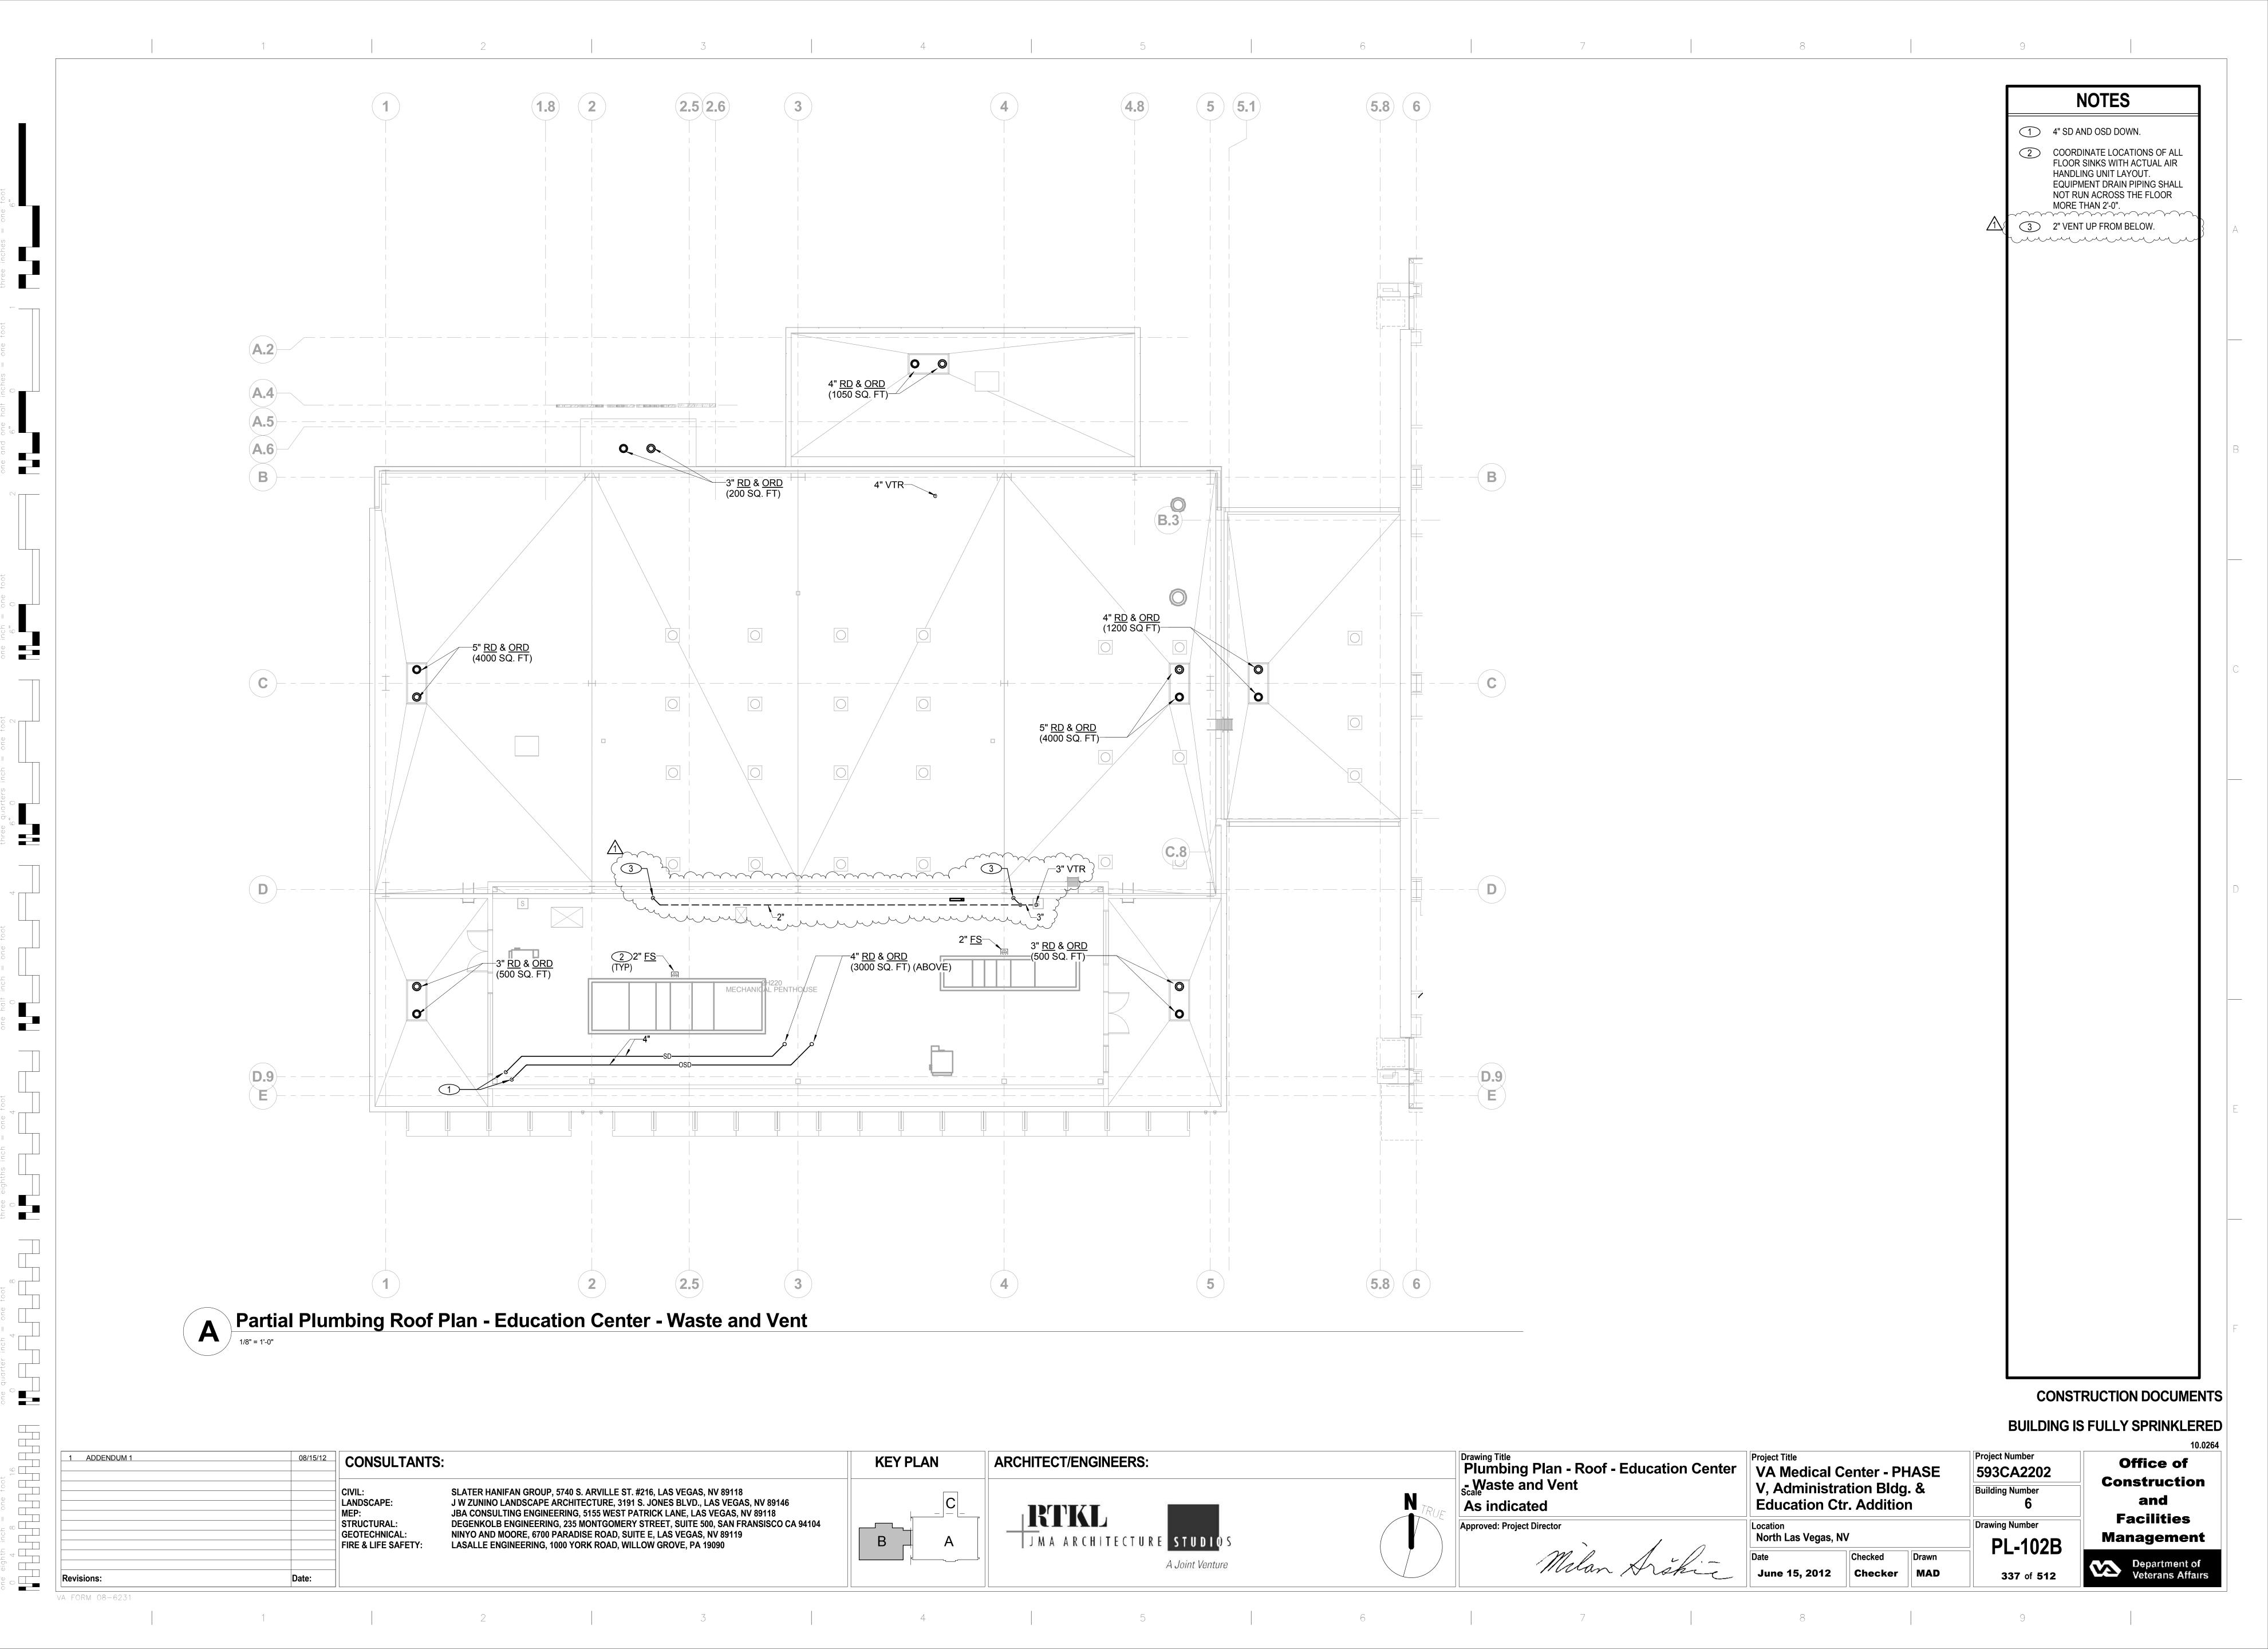


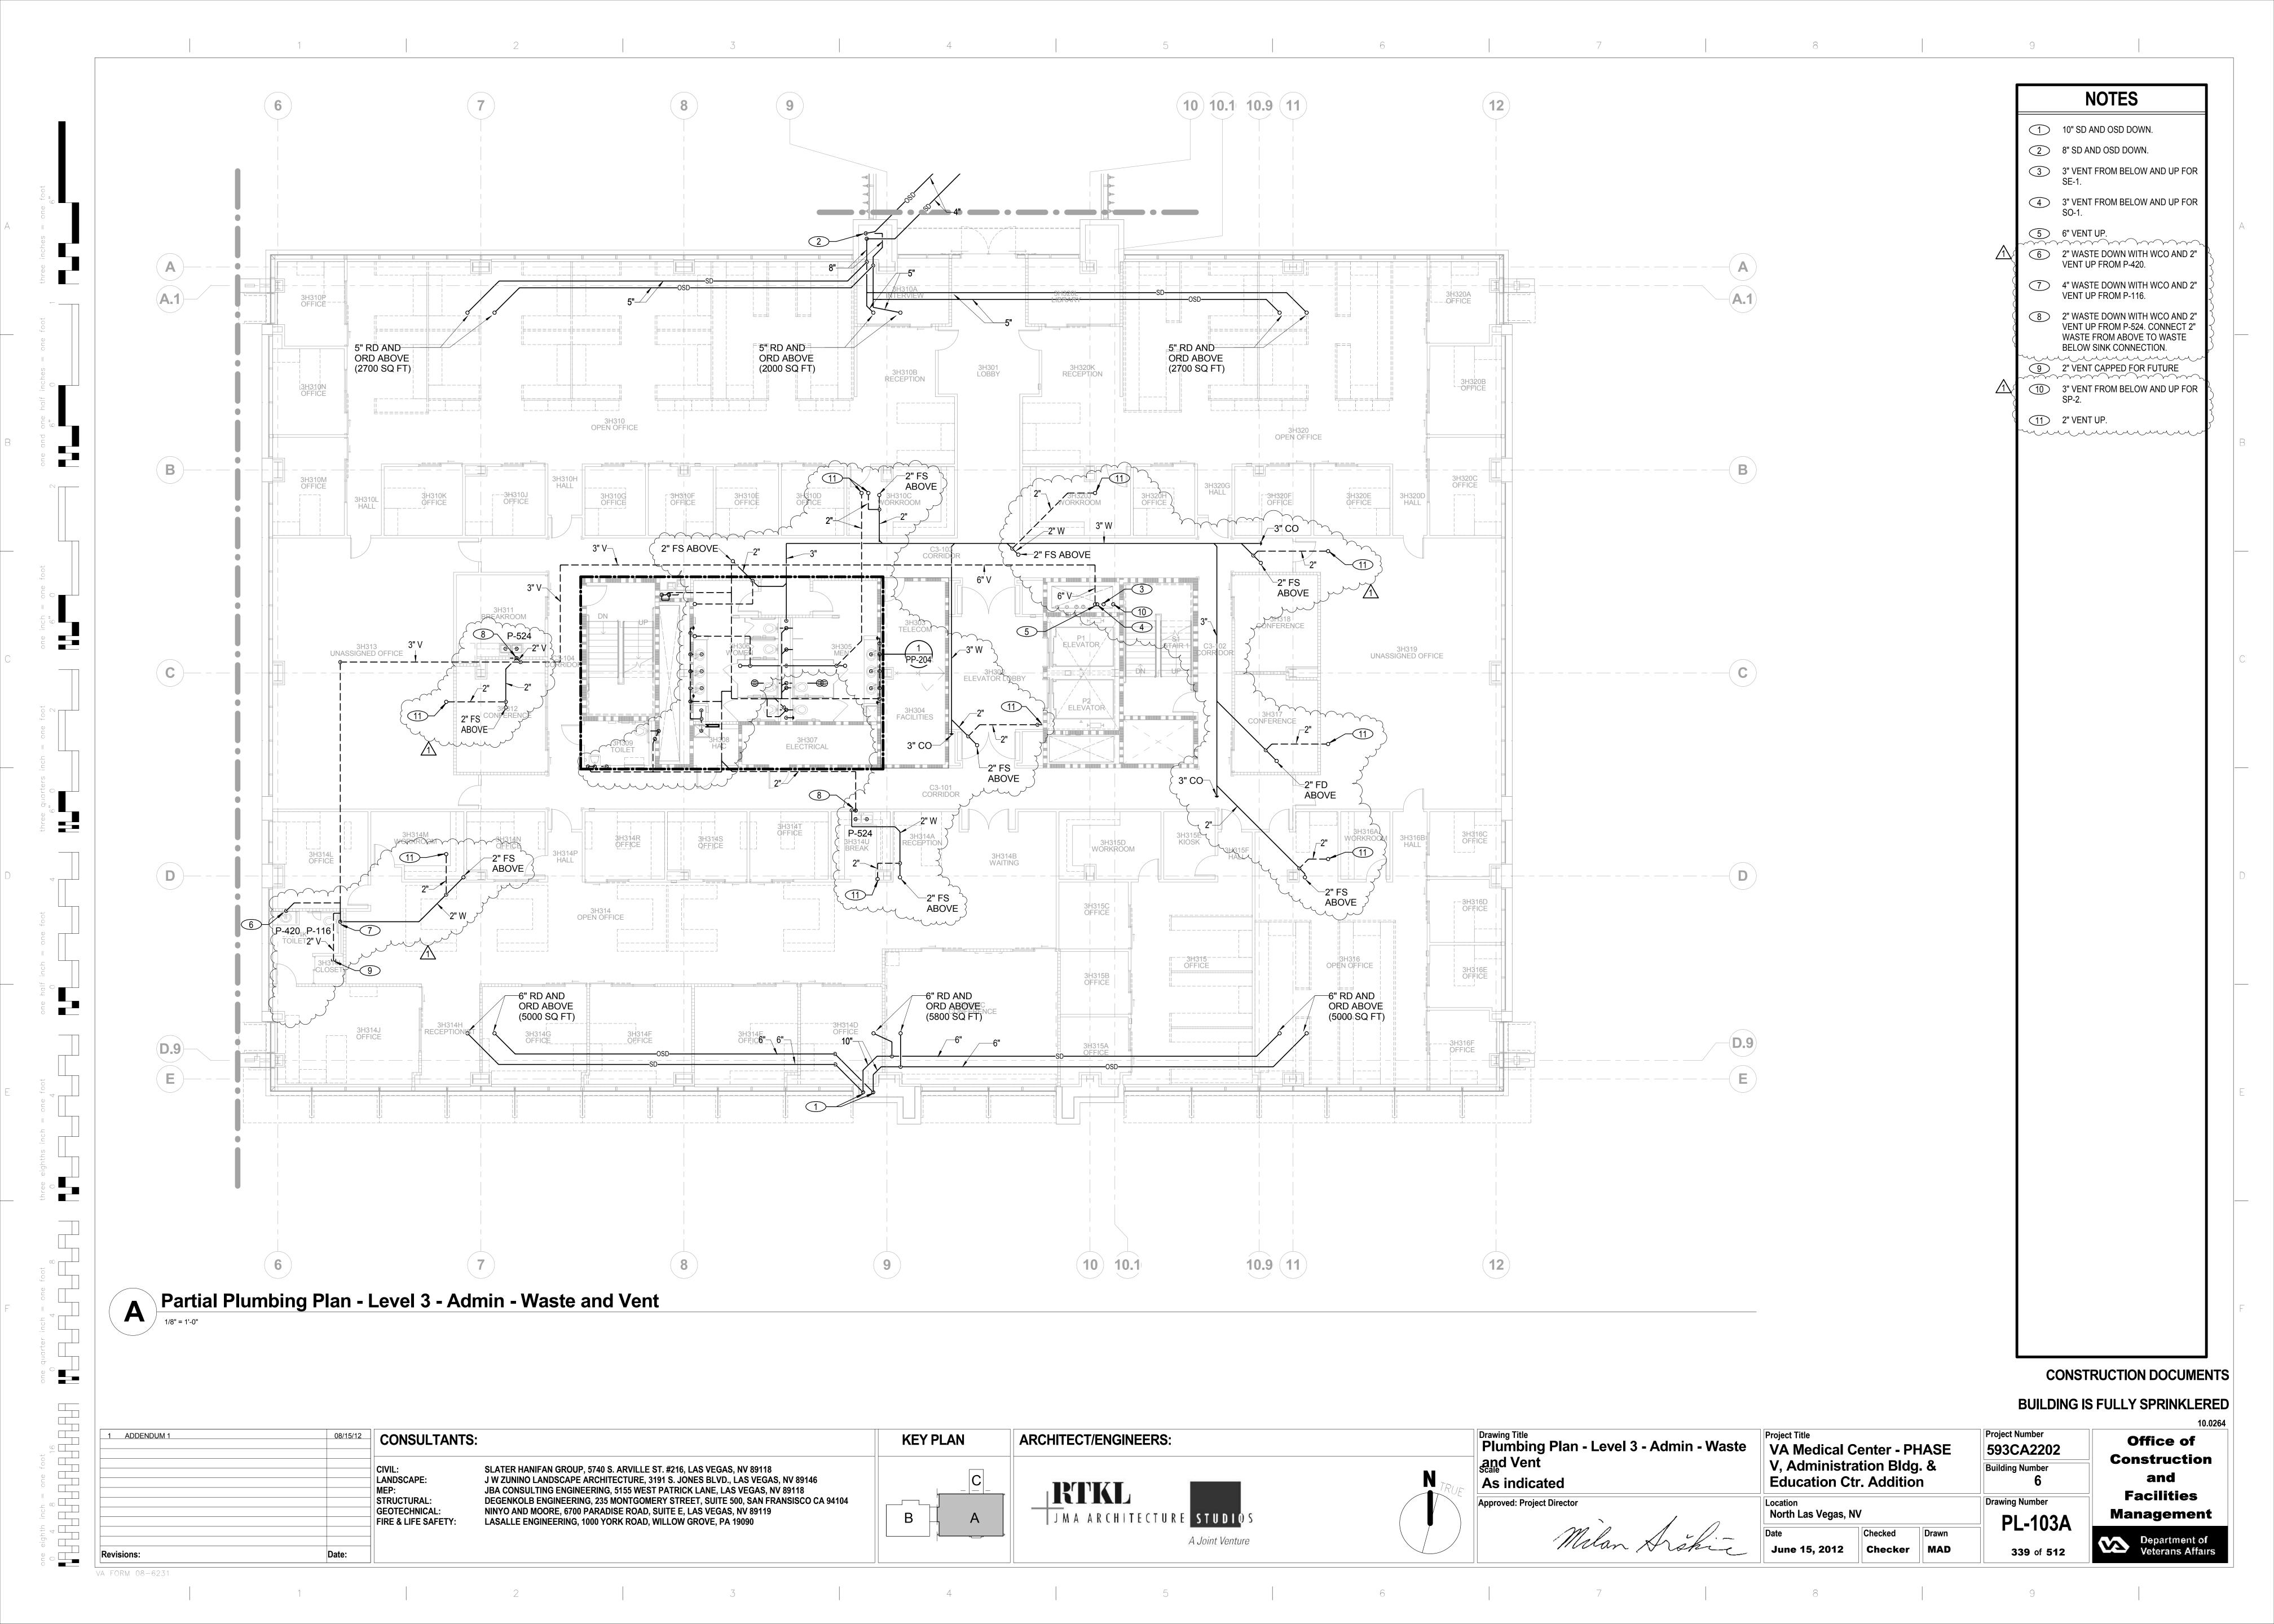

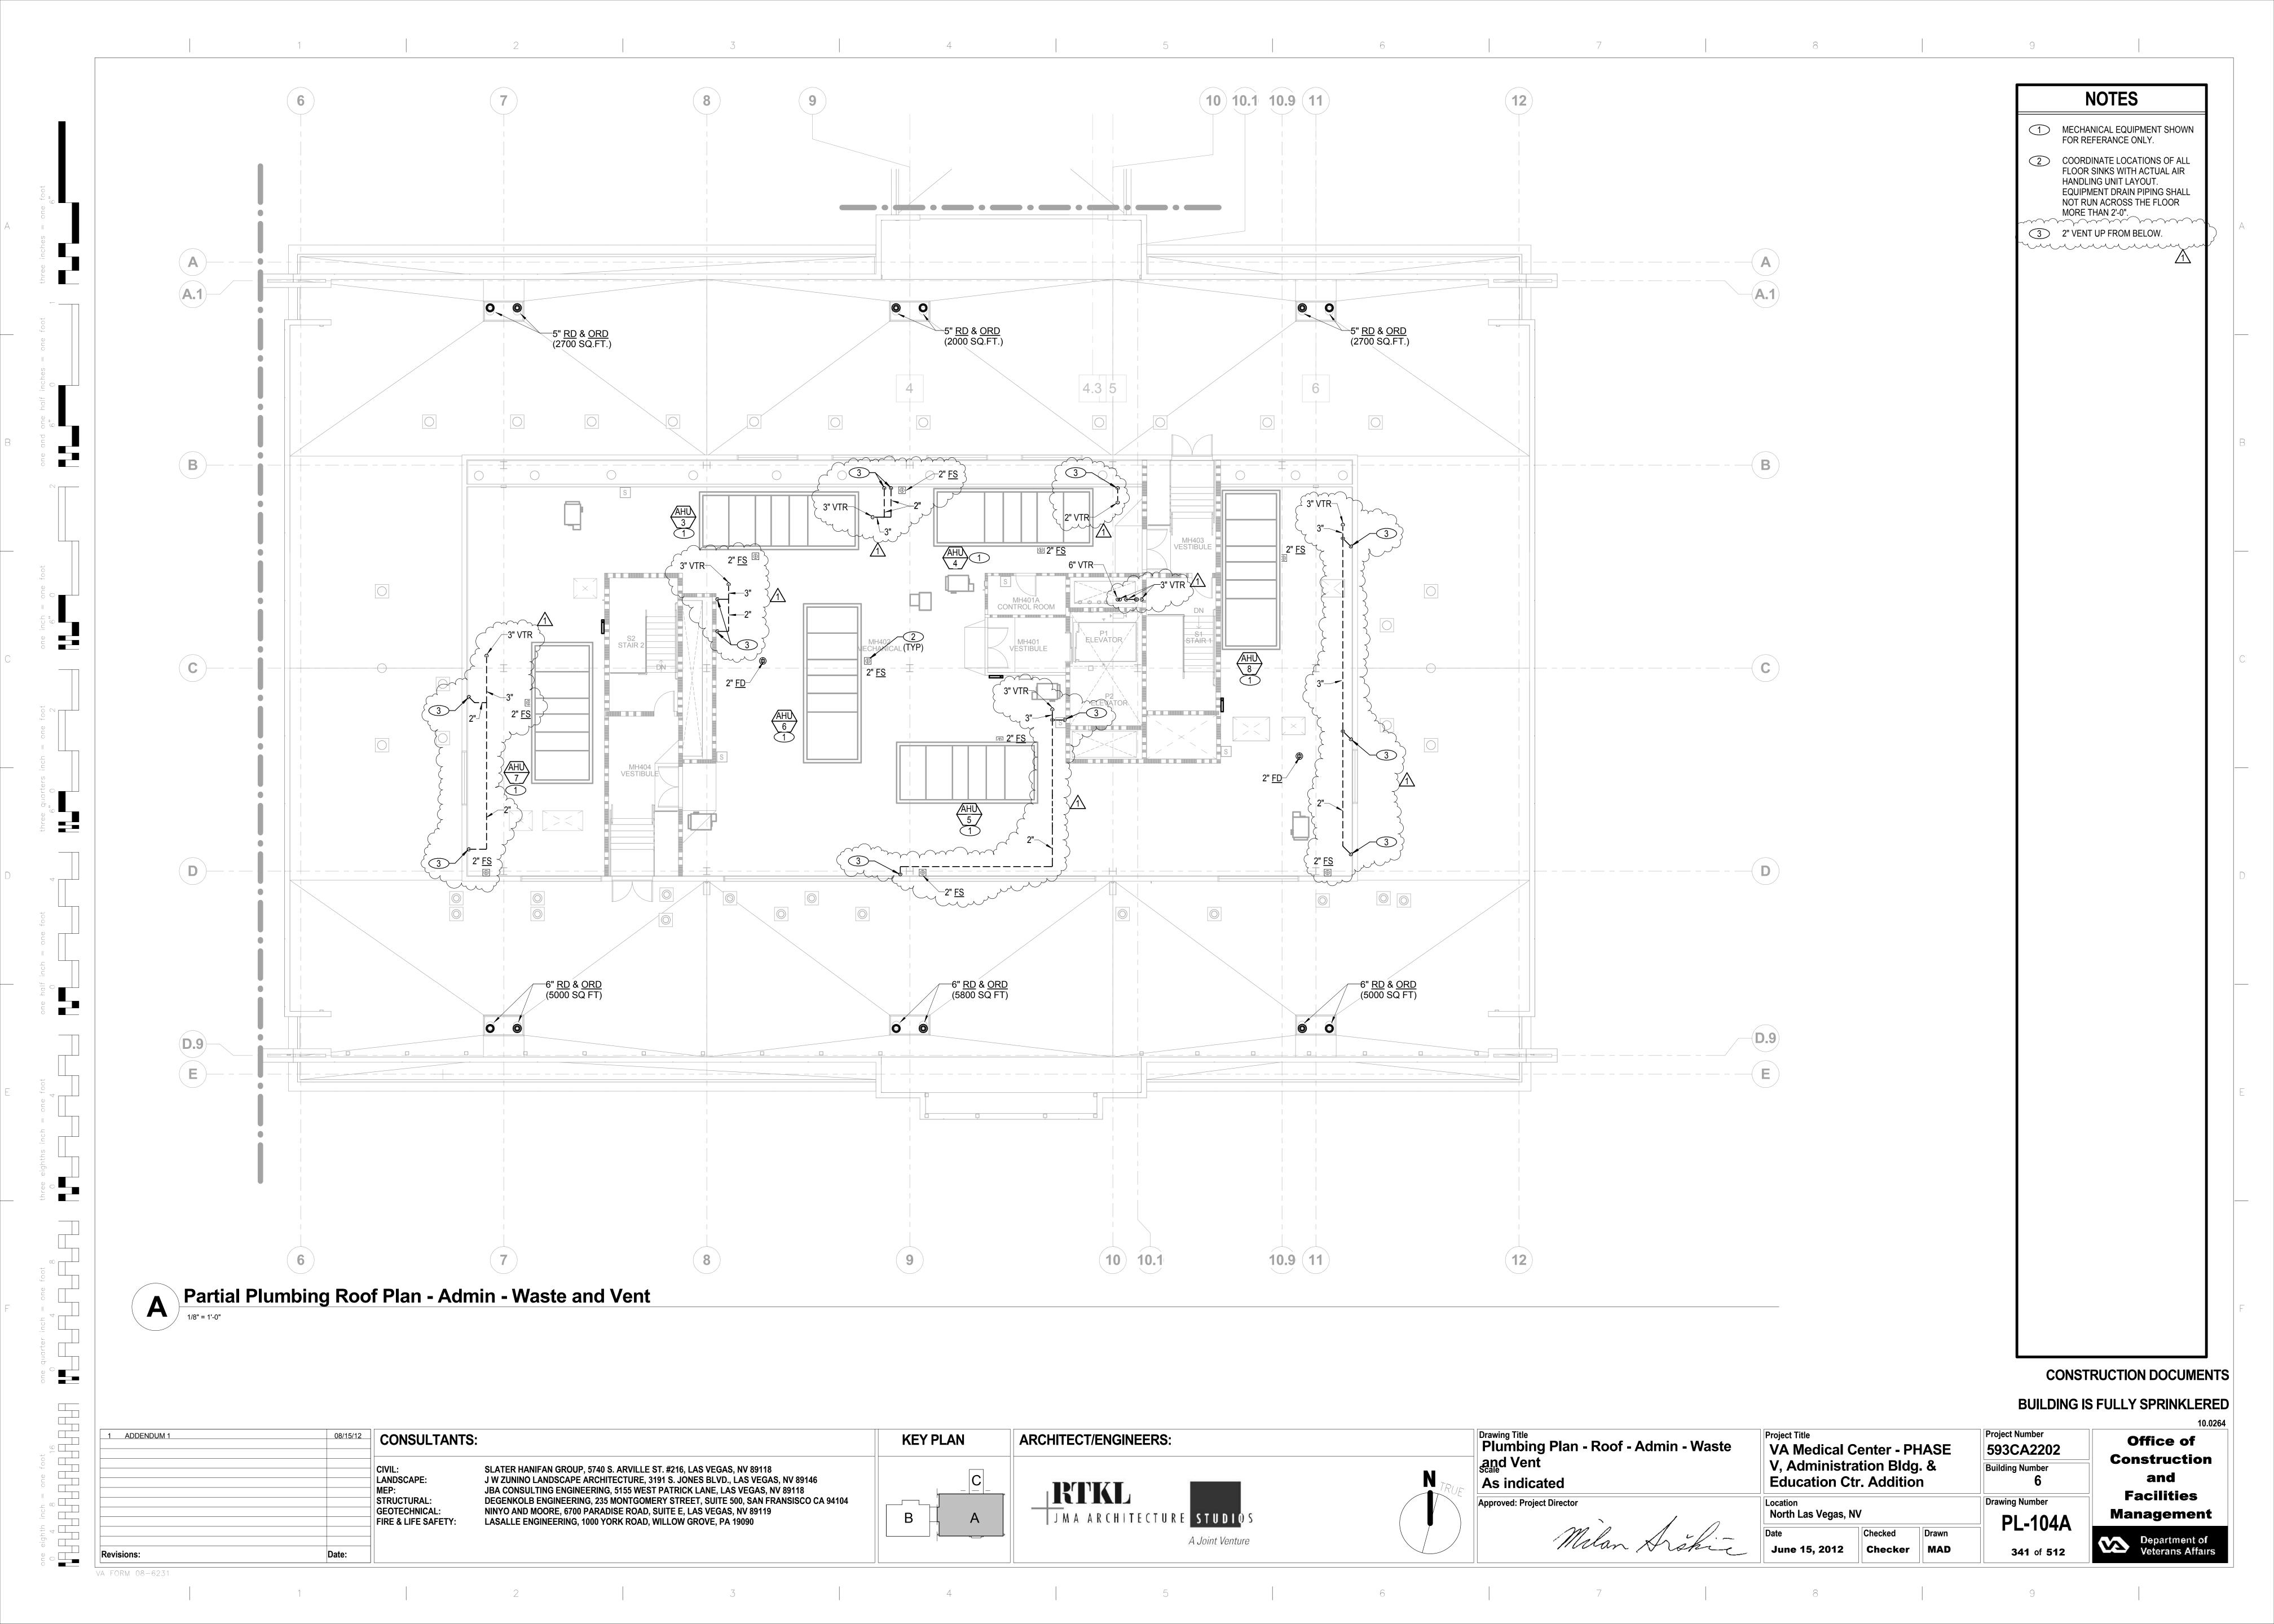

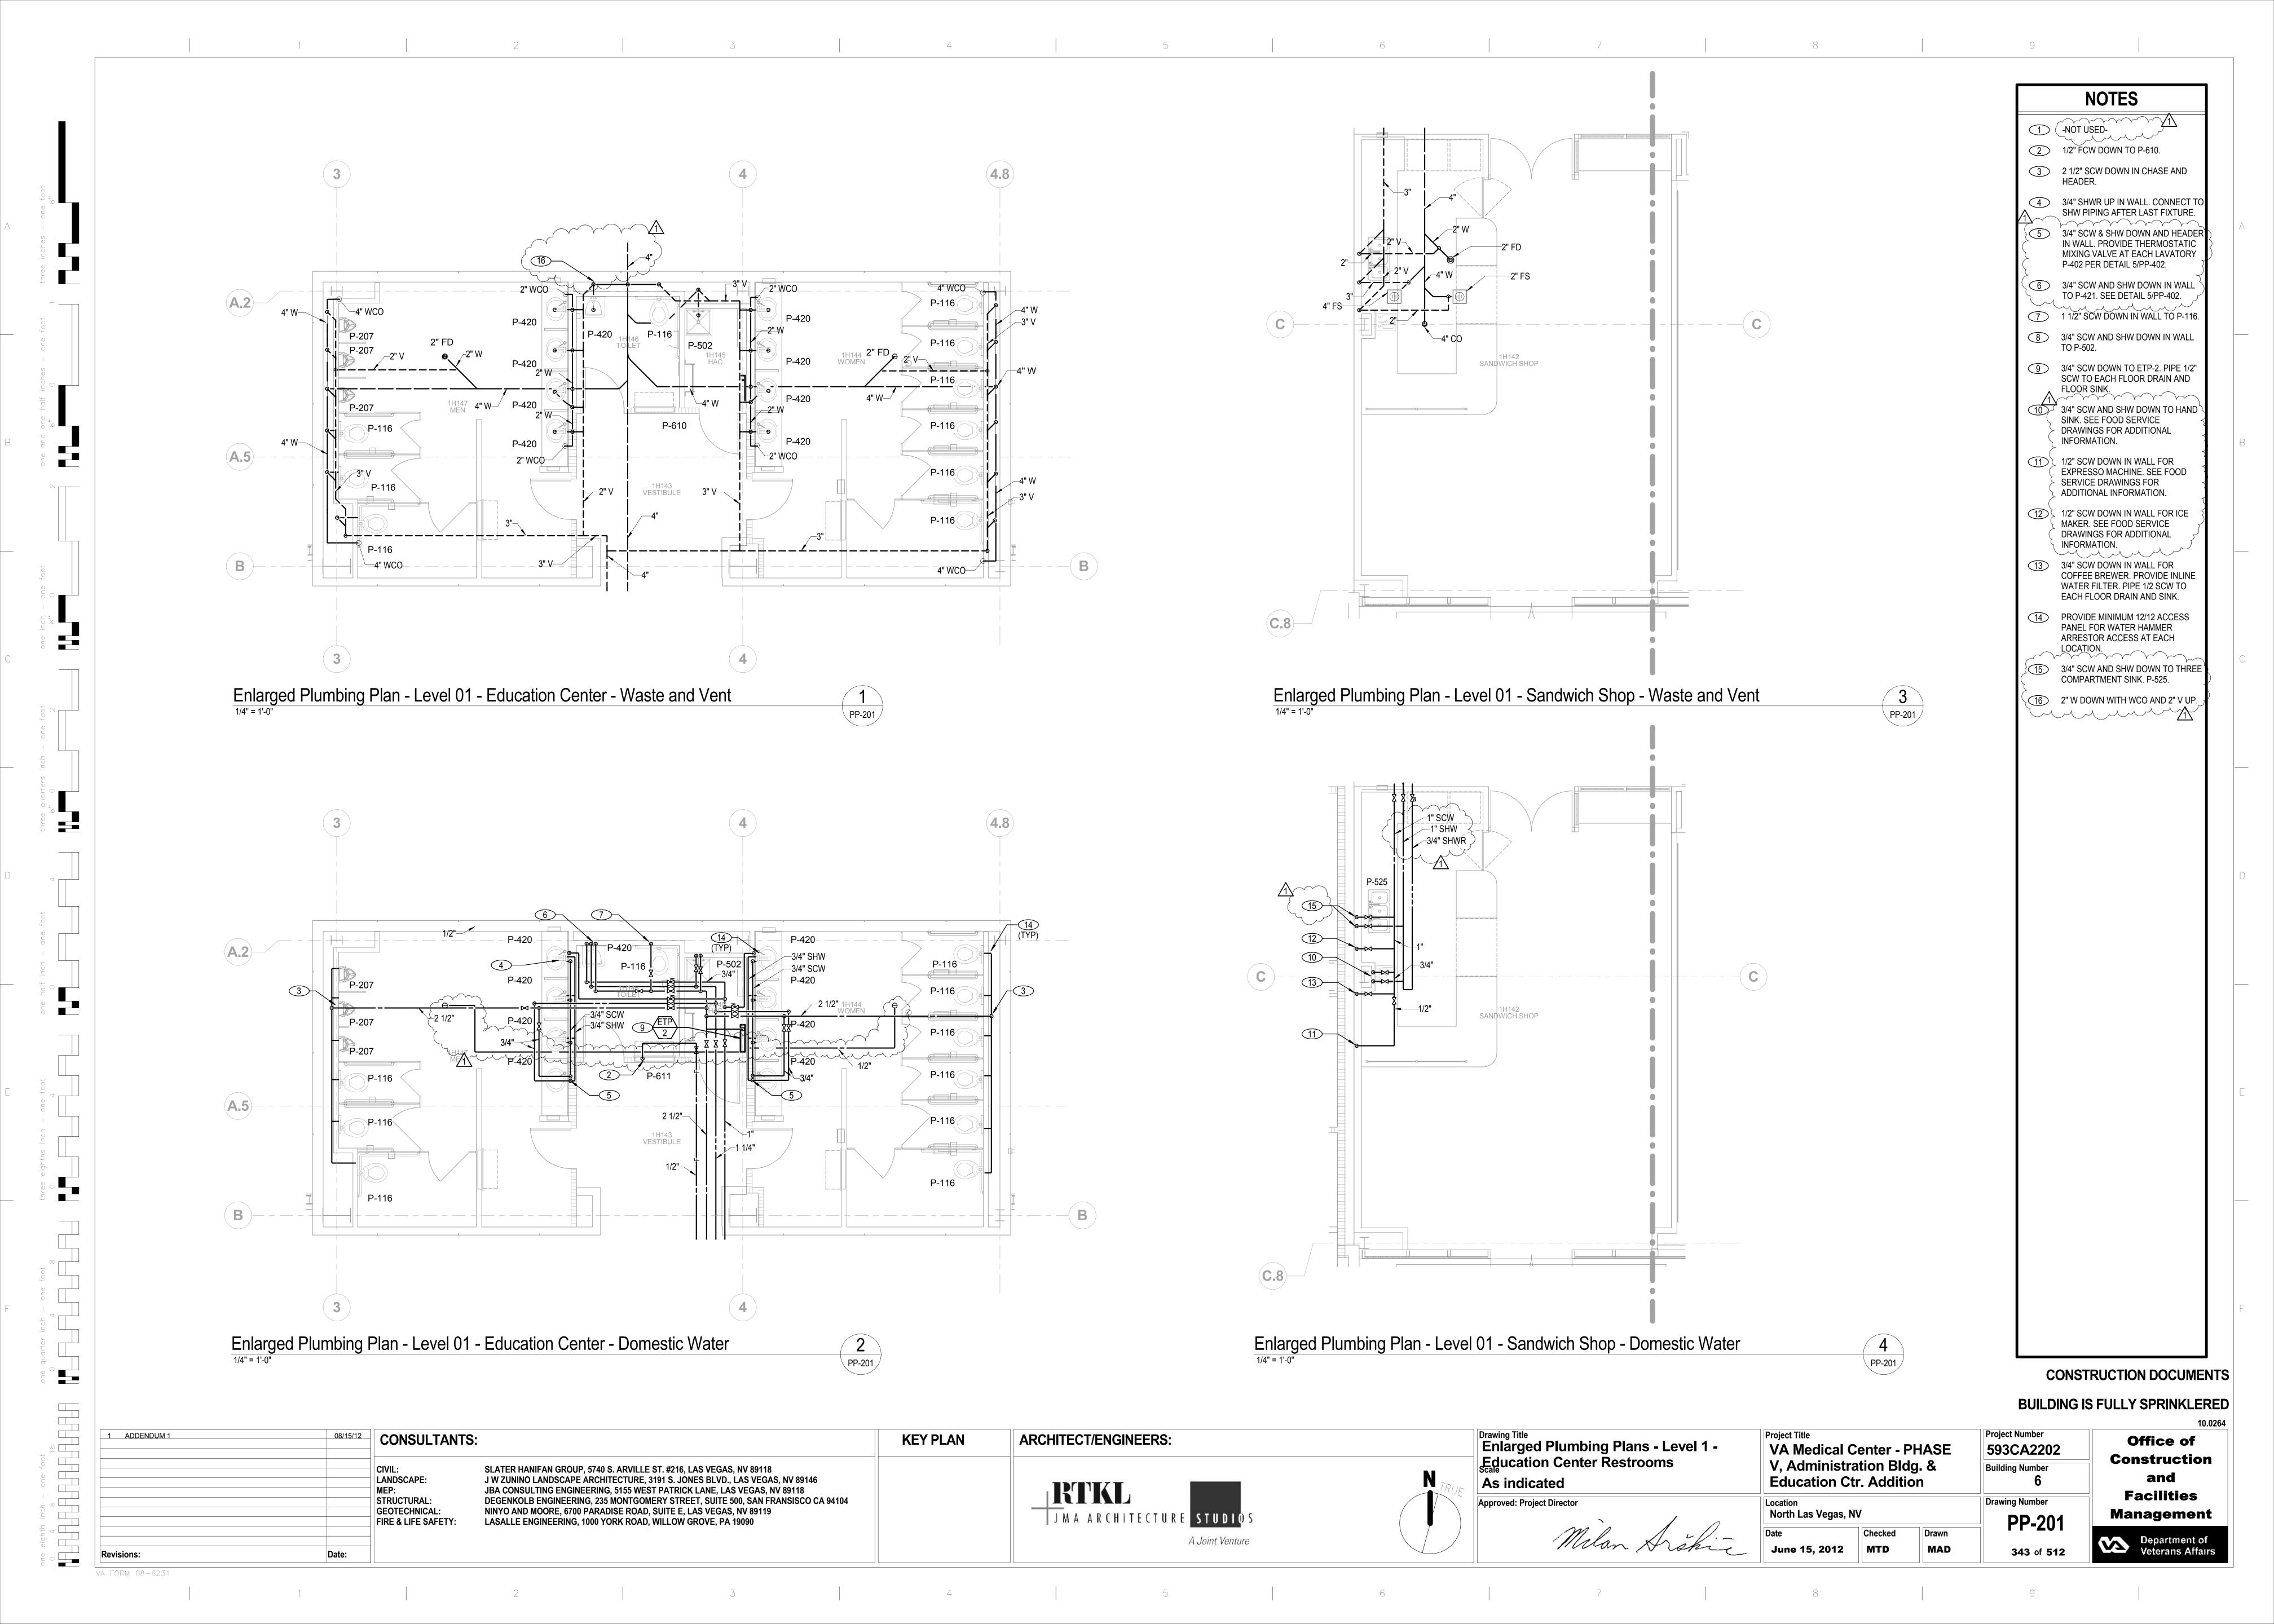

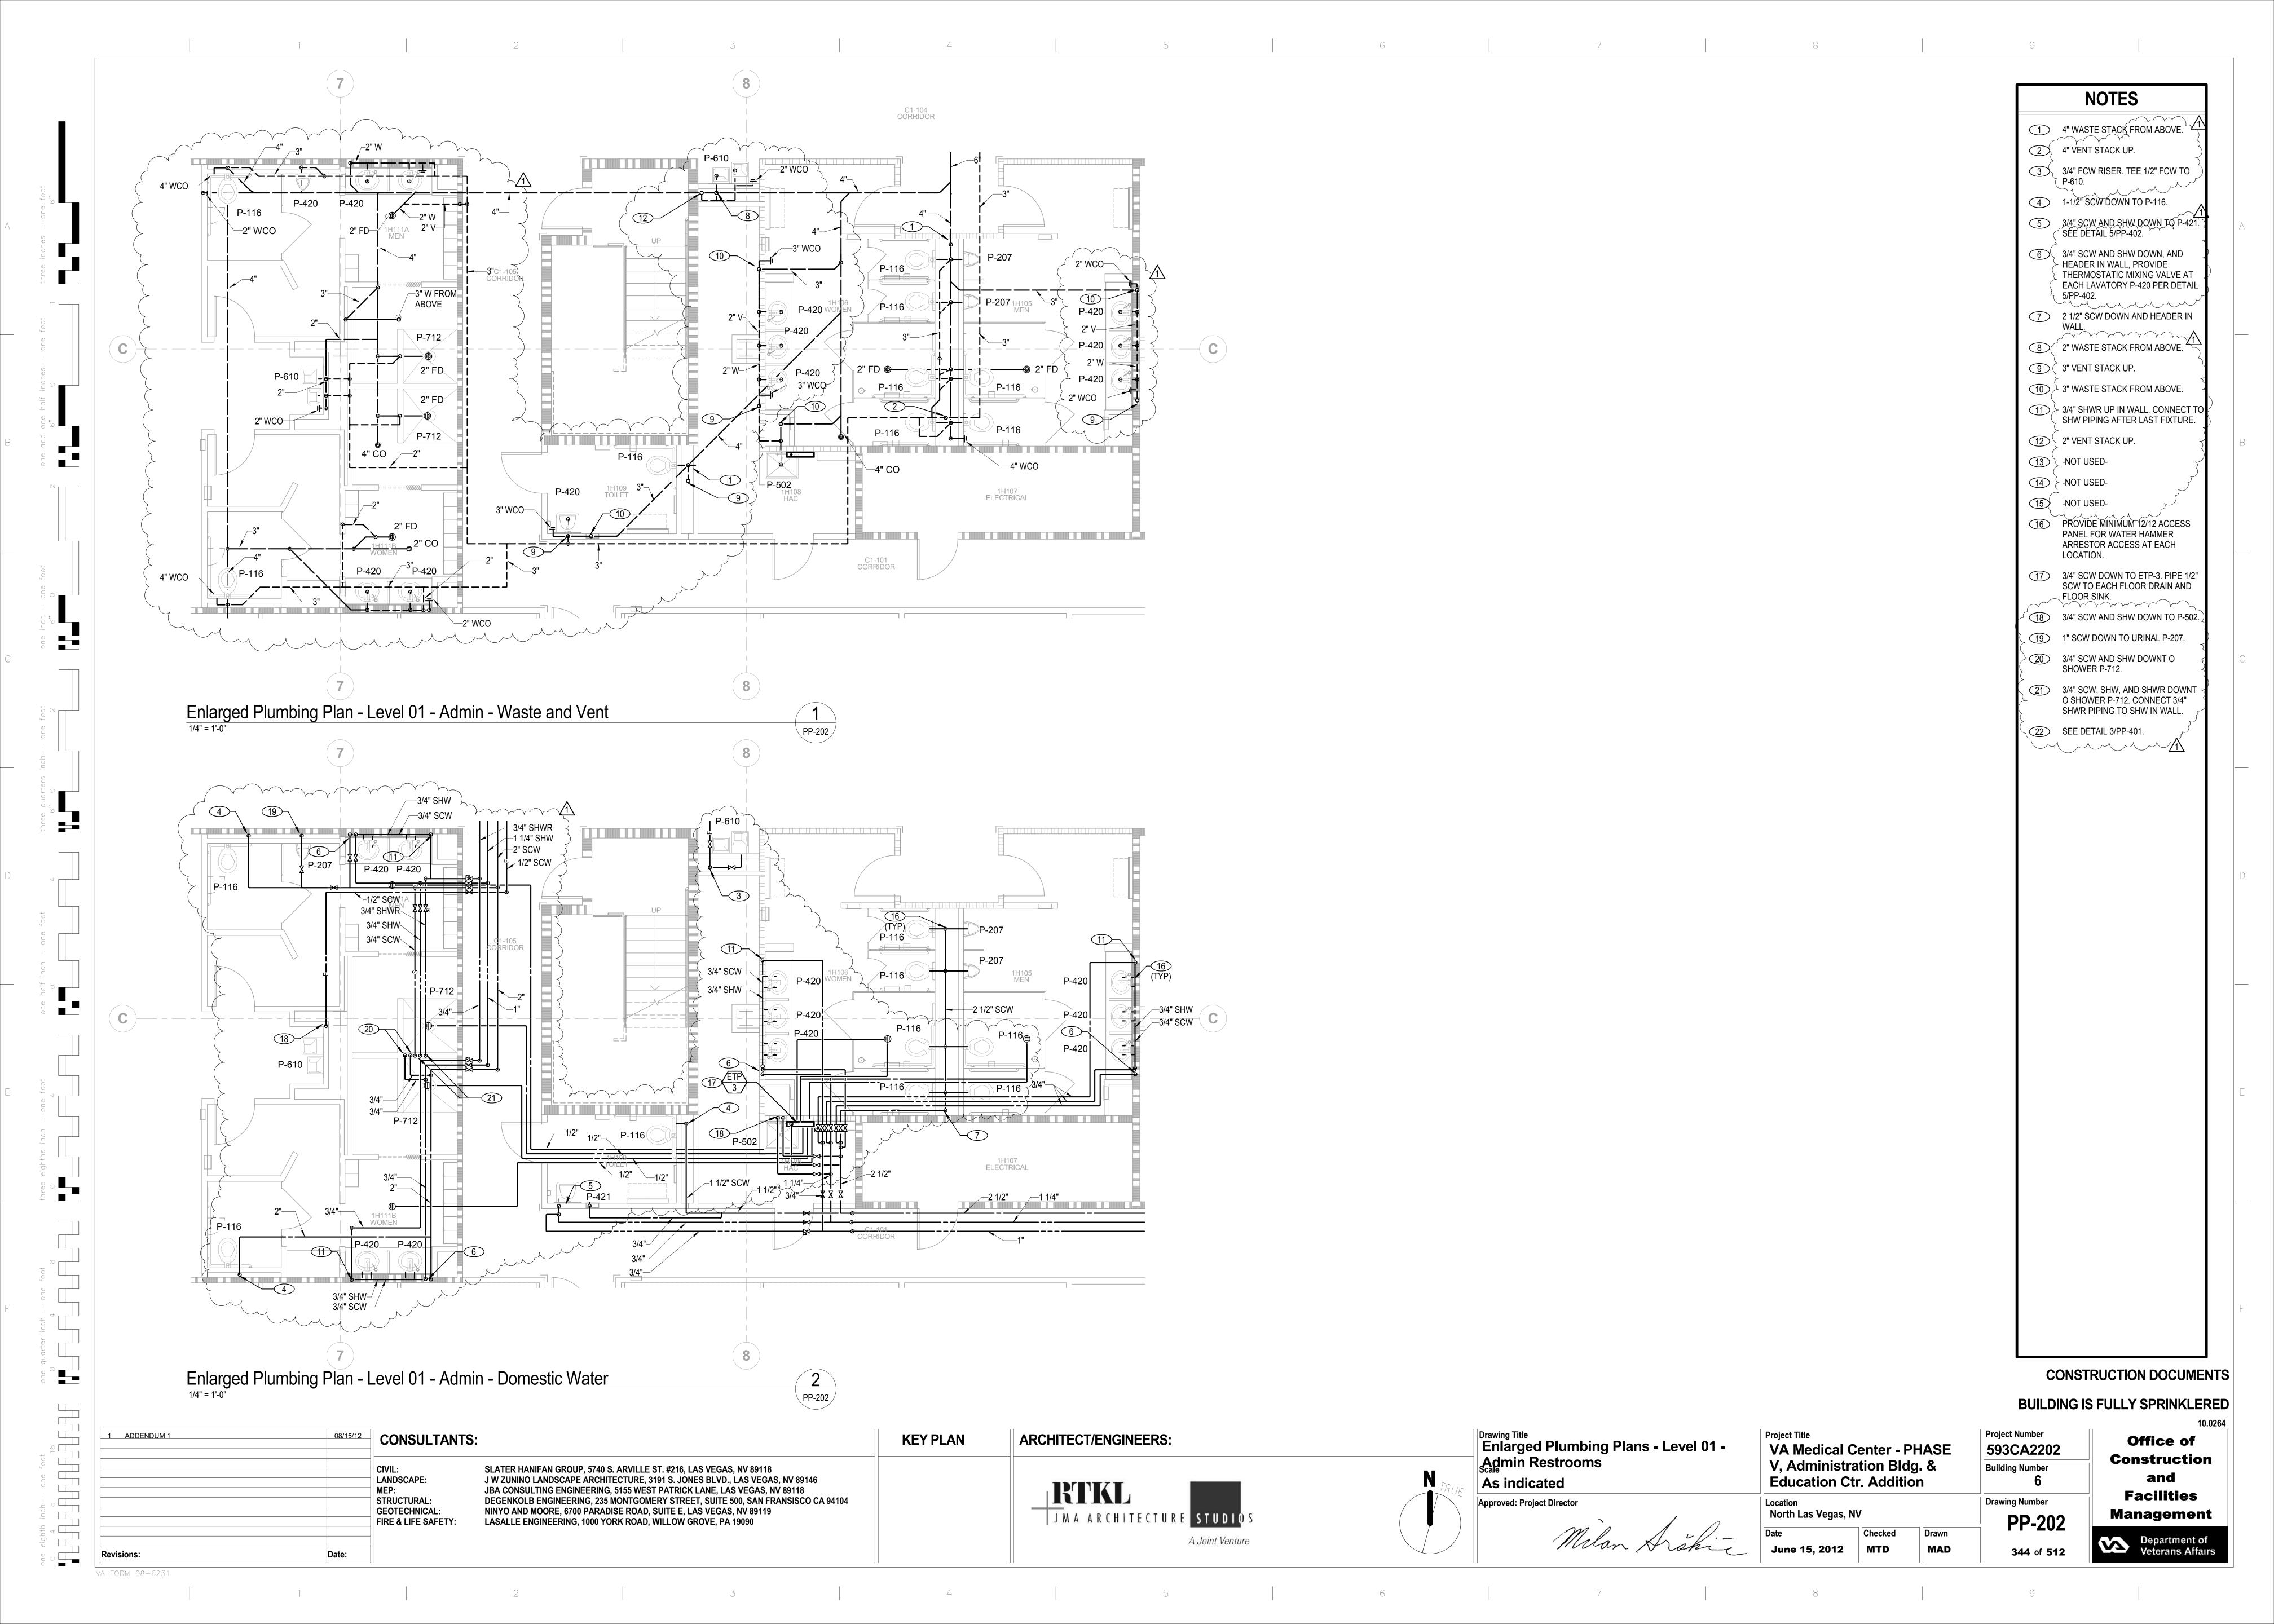

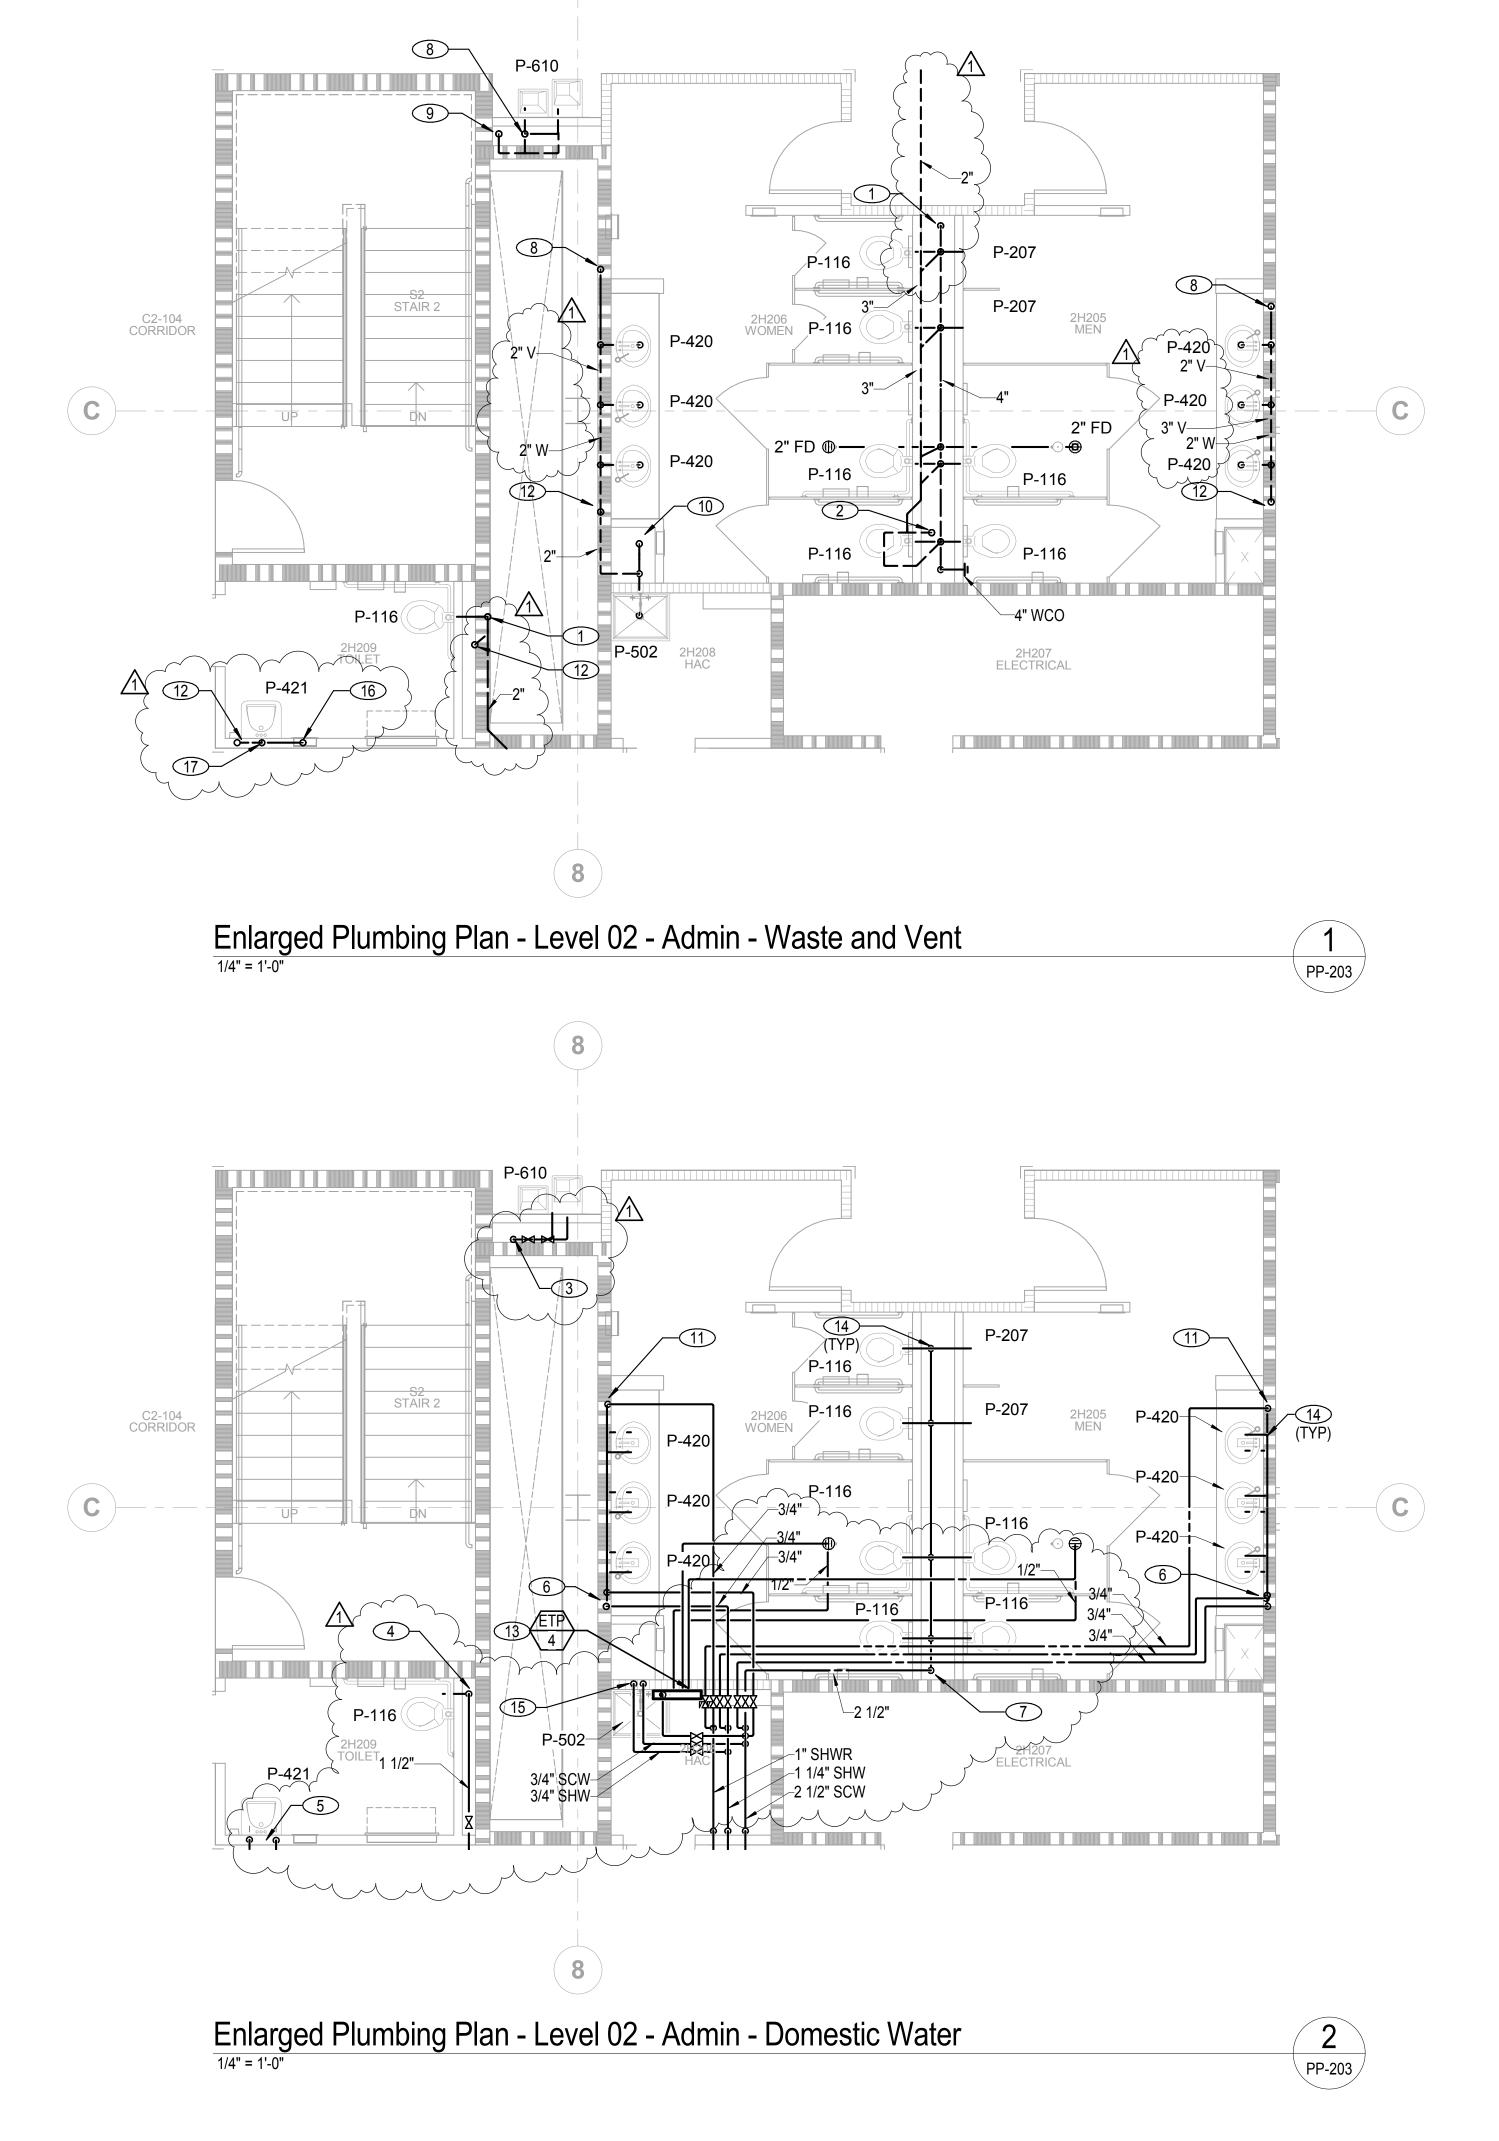

one eignin inch = one toot

4 8 16

VA FORM 08-6231

1 4" WASTE STACK. 2 4" VENT STACK. 3/4" FCW RISER. TEE 1/2" FCW TO 1-1/2" SCW DOWN TO P-116. 5 3/4" SCW AND SHW DOWN IN WALL TO P-421. SEE DETAIL 5/PP-402. 6 3/4" CW AND HW DOWN, AND HEADER IN WALL, PROVIDE THERMOSTATIC MIXING VALVE AT EACH LAVATORY P-420 PER DETAIL 7 2 1/2" SCW DOWN IN CHASE AND HEADER. 8 2" WASTE STACK. 9 2" VENT STACK.

10 3" WASTE STACK.

11 3/4" HWR UP IN WALL. CONNECT TO ackslash SHW PIPING AFTER LAST FIXTURE

12 3" VENT STACK.

3/4" SCW DOWN TO ETP-4. PIPE 1/2" SCW TO EACH FLOOR DRAIN AND FLOOR SINK.

PROVIDE MINIMUM 12/12 ACCESS PANEL FOR WATER HAMMER ARRESTOR ACCESS AT EACH

15 3/4" SCW AND SHW DOWNT O P-502.

3" WASTE STACK.


2" W DOWN WITH WCO AND 2" V UP FROM P-421.


**CONSTRUCTION DOCUMENTS** 

**345** of **512** 

**BUILDING IS FULLY SPRINKLERED** 

Project Number Drawing Title
Enlarged Plumbing Plans - Level 02 -08/15/12 CONSULTANTS: ARCHITECT/ENGINEERS: ADDENDUM 1 **KEY PLAN** Office of VA Medical Center - PHASE 593CA2202 Admin Restrooms Construction V, Administration Bldg. & **Building Number** SLATER HANIFAN GROUP, 5740 S. ARVILLE ST. #216, LAS VEGAS, NV 89118 CIVIL: and J W ZUNINO LANDSCAPE ARCHITECTURE, 3191 S. JONES BLVD., LAS VEGAS, NV 89146 **Education Ctr. Addition** LANDSCAPE: As indicated RTKL JBA CONSULTING ENGINEERING, 5155 WEST PATRICK LANE, LAS VEGAS, NV 89118 **Facilities** DEGENKOLB ENGINEERING, 235 MONTGOMERY STREET, SUITE 500, SAN FRANSISCO CA 94104 STRUCTURAL: Drawing Number Approved: Project Director Location
North Las Vegas, NV GEOTECHNICAL: NINYO AND MOORE, 6700 PARADISE ROAD, SUITE E, LAS VEGAS, NV 89119 JMA ARCHITECTURE STUDIOS Management **PP-203** LASALLE ENGINEERING, 1000 YORK ROAD, WILLOW GROVE, PA 19090 FIRE & LIFE SAFETY: Department of Veterans Affairs A Joint Venture

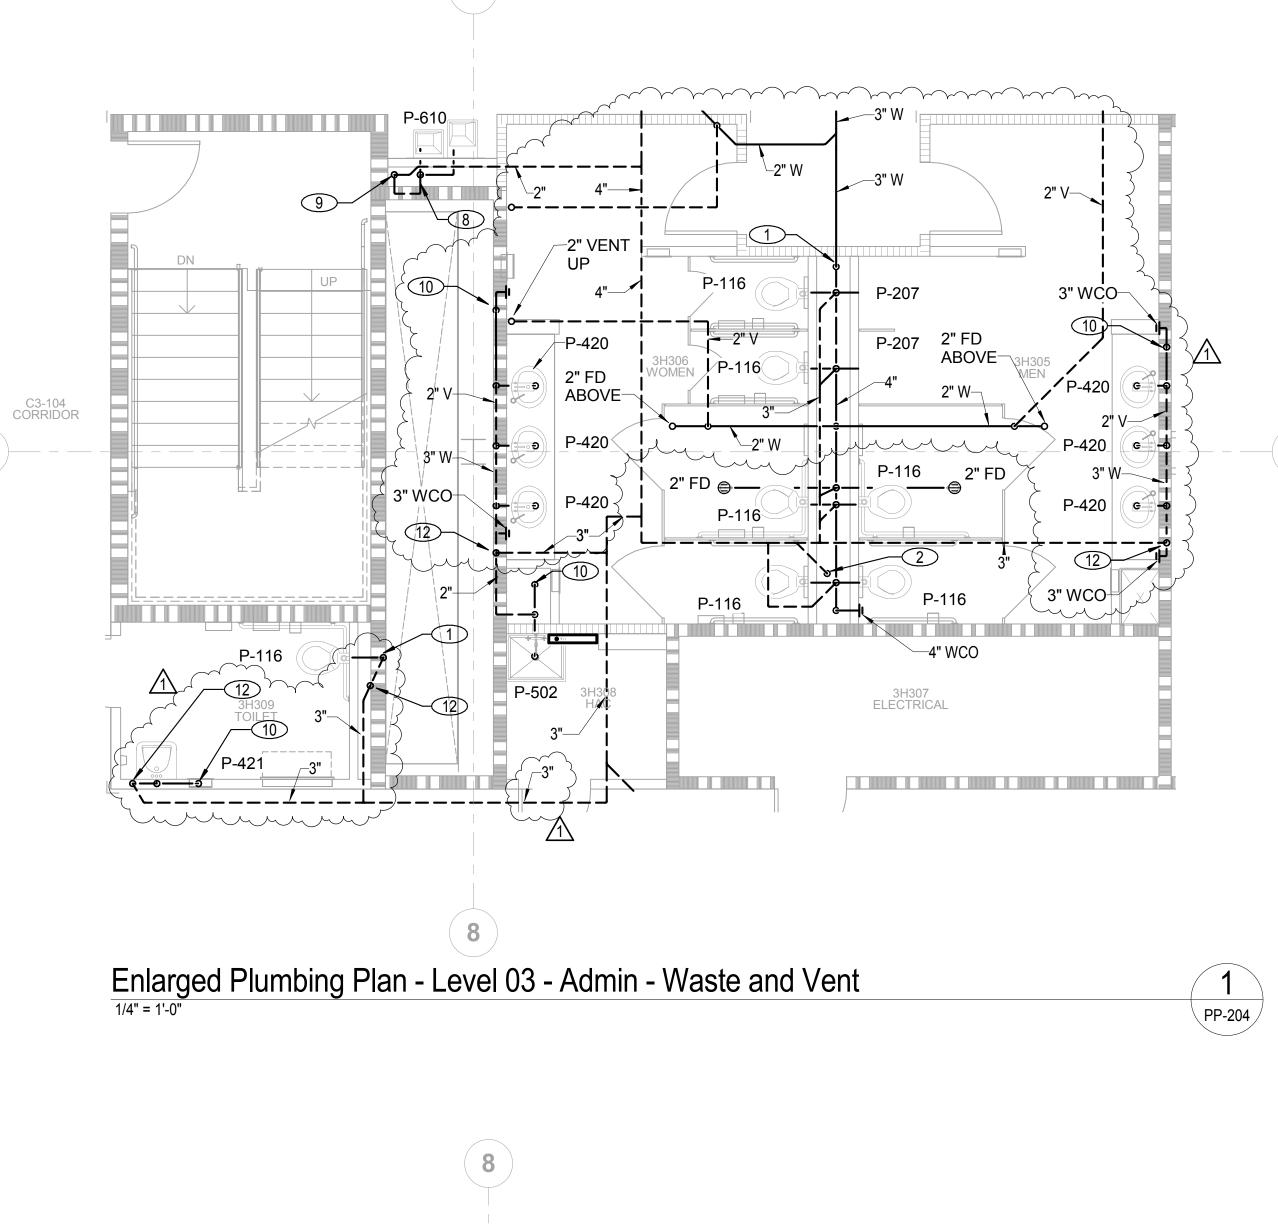

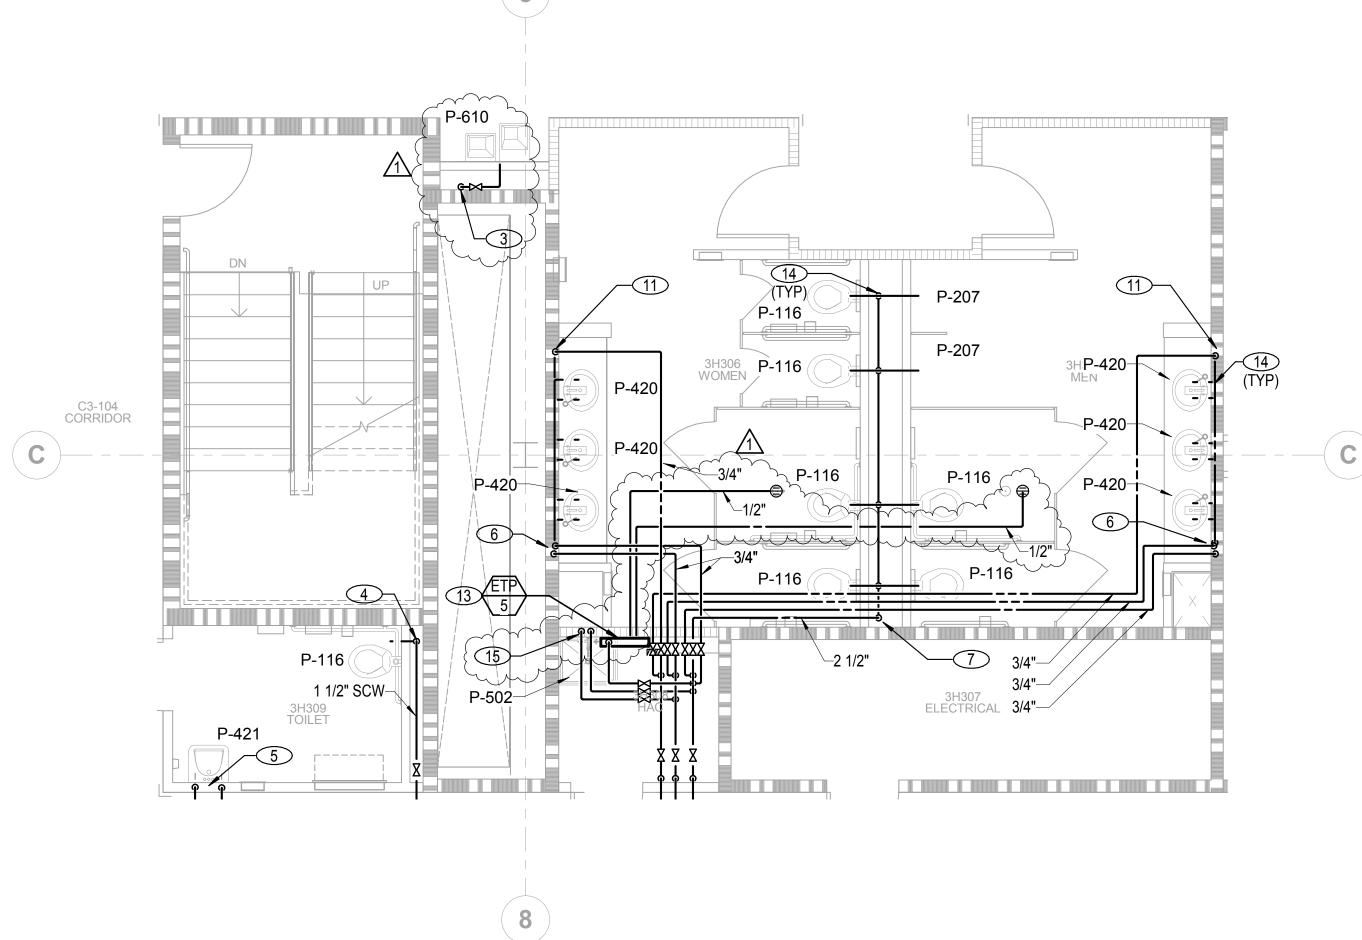

Enlarged Plumbing Plan - Level 03 - Admin - Domestic Water

VA FORM 08-6231

CONSTRUCTION DOCUMENTS


**BUILDING IS FULLY SPRINKLERED** 

1 ADDENDUM 1	08/15/12	CONSULTANT	S:	KEY PLAN	ARCHITECT/ENGINEERS:		Drawing Title Enlarged Plumbing Plans - Level 03 -	Project Title  VA Medical Center - PHASE	Project Number 593CA2202	Office of
		CIVIL: LANDSCAPE: MEP:	SLATER HANIFAN GROUP, 5740 S. ARVILLE ST. #216, LAS VEGAS, NV 89118 J W ZUNINO LANDSCAPE ARCHITECTURE, 3191 S. JONES BLVD., LAS VEGAS, NV 89146 JBA CONSULTING ENGINEERING, 5155 WEST PATRICK LANE, LAS VEGAS, NV 89118		RTKL	N TRUE	Admin Restrooms As indicated	V, Administration Bldg. & Education Ctr. Addition	Building Number  6	Construction and
		STRUCTURAL: GEOTECHNICAL: FIRE & LIFE SAFETY:	DEGENKOLB ENGINEERING, 235 MONTGOMERY STREET, SUITE 500, SAN FRANSISCO CA 94104 NINYO AND MOORE, 6700 PARADISE ROAD, SUITE E, LAS VEGAS, NV 89119 LASALLE ENGINEERING, 1000 YORK ROAD, WILLOW GROVE, PA 19090		J M A A R CHITECTURE STUDIOS		Approved: Project Director	Location North Las Vegas, NV	Drawing Number PP-204	Facilities  Management
Revisions:	Date:				A Joint Venture		Molan Arskie	June 15, 2012 Checked Drawn MAD	346 of 512	Department of Veterans Affairs

 1
 5

 3
 9

1 4" WASTE DOWN. 2 4" VENT FROM BELOW. 3 3/4" FCW FROM BELOW. TEE 1/2" FCW TO P-610. 4 1-1/2" SCW DOWN TO P-116. 5 3/4" SCW AND SHW DOWN IN WALL TO P-421. SEE DETAIL 5/PP-402. 6 3/4" CW AND HW DOWN, AND HEADER IN WALL, PROVIDE THERMOSTATIC MIXING VALVE AT EACH LAVATORY P-420 PER DETAIL 5/PP-402. 7 2 1/2" SCW DOWN IN CHASE AND HEADER. 8 2" WASTE DOWN. 2" VENT FROM BELOW. 10 3" WASTE DOWN. (11) 3/4" HWR UP IN WALL. CONNECT TO SHW PIPING AFTER LAST FIXTURE. 12 3" VENT FROM BELOW. 13 3/4" SCW DOWN TO ETP-5. PIPE 1/2 SCW TO EACH FLOOR DRAIN AND PROVIDE MINIMUM 12/12 ACCESS PANEL FOR WATER HAMMER ARRESTER ACCESS AT EACH LOCATION. 15 3/4" SCW AND SHW DOWN TO P-502. 

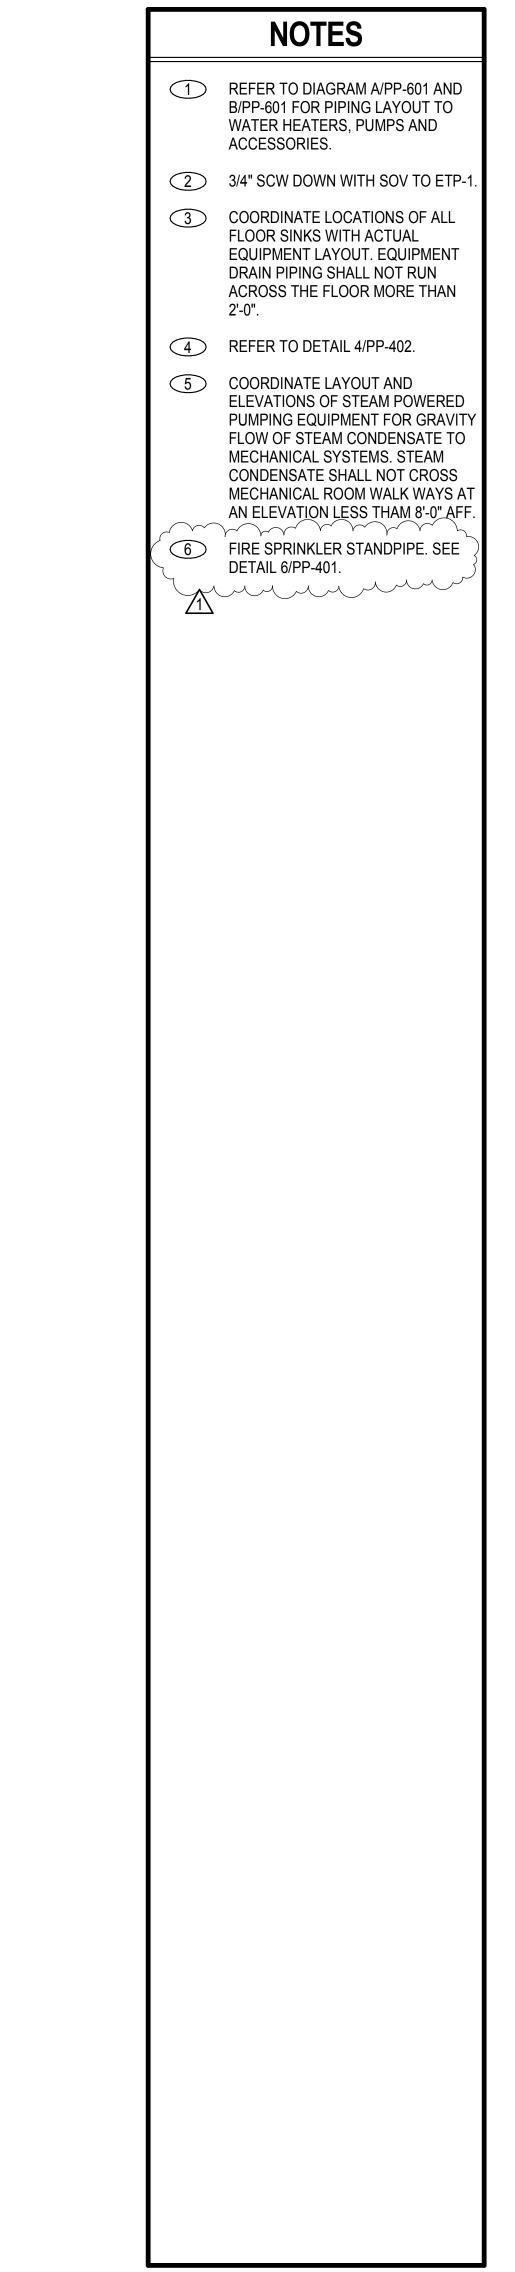



**BUILDING IS FULLY SPRINKLERED** 

#### Drawing Title Enlarged Plumbing Plans - Basement Mechanical Room Project Number Project Title 08/15/12 CONSULTANTS: ADDENDUM 1 **KEY PLAN** ARCHITECT/ENGINEERS: Office of VA Medical Center - PHASE 593CA2202 Construction V, Administration Bldg. & **Building Number** SLATER HANIFAN GROUP, 5740 S. ARVILLE ST. #216, LAS VEGAS, NV 89118 CIVIL: and J W ZUNINO LANDSCAPE ARCHITECTURE, 3191 S. JONES BLVD., LAS VEGAS, NV 89146 **Education Ctr. Addition** LANDSCAPE: As indicated RTKL JBA CONSULTING ENGINEERING, 5155 WEST PATRICK LANE, LAS VEGAS, NV 89118 DEGENKOLB ENGINEERING, 235 MONTGOMERY STREET, SUITE 500, SAN FRANSISCO CA 94104 MEP: **Facilities** STRUCTURAL: Drawing Number Approved: Project Director Location North Las Vegas, NV J M A A R C H I T E C T U R E S T U D I O S GEOTECHNICAL: NINYO AND MOORE, 6700 PARADISE ROAD, SUITE E, LAS VEGAS, NV 89119 LASALLE ENGINEERING, 1000 YORK ROAD, WILLOW GROVE, PA 19090 Management **PP-205** FIRE & LIFE SAFETY: Department of Veterans Affairs A Joint Venture **347** of **512**

S1 STAIR 1 180 SF /

one eighth inch = one foot


0 4 8 16

VA FORM 08-6231

Enlarged Plumbing Plan - Basement - Mechanical Room

**NOTICE** 

PIPING ISOMETRIC FOR REFERENCE ONLY. USE FLOOR PLANS, DETAILS, SCHEMATICS AND SPECIFICATIONS FOR CONSTRUCTION.

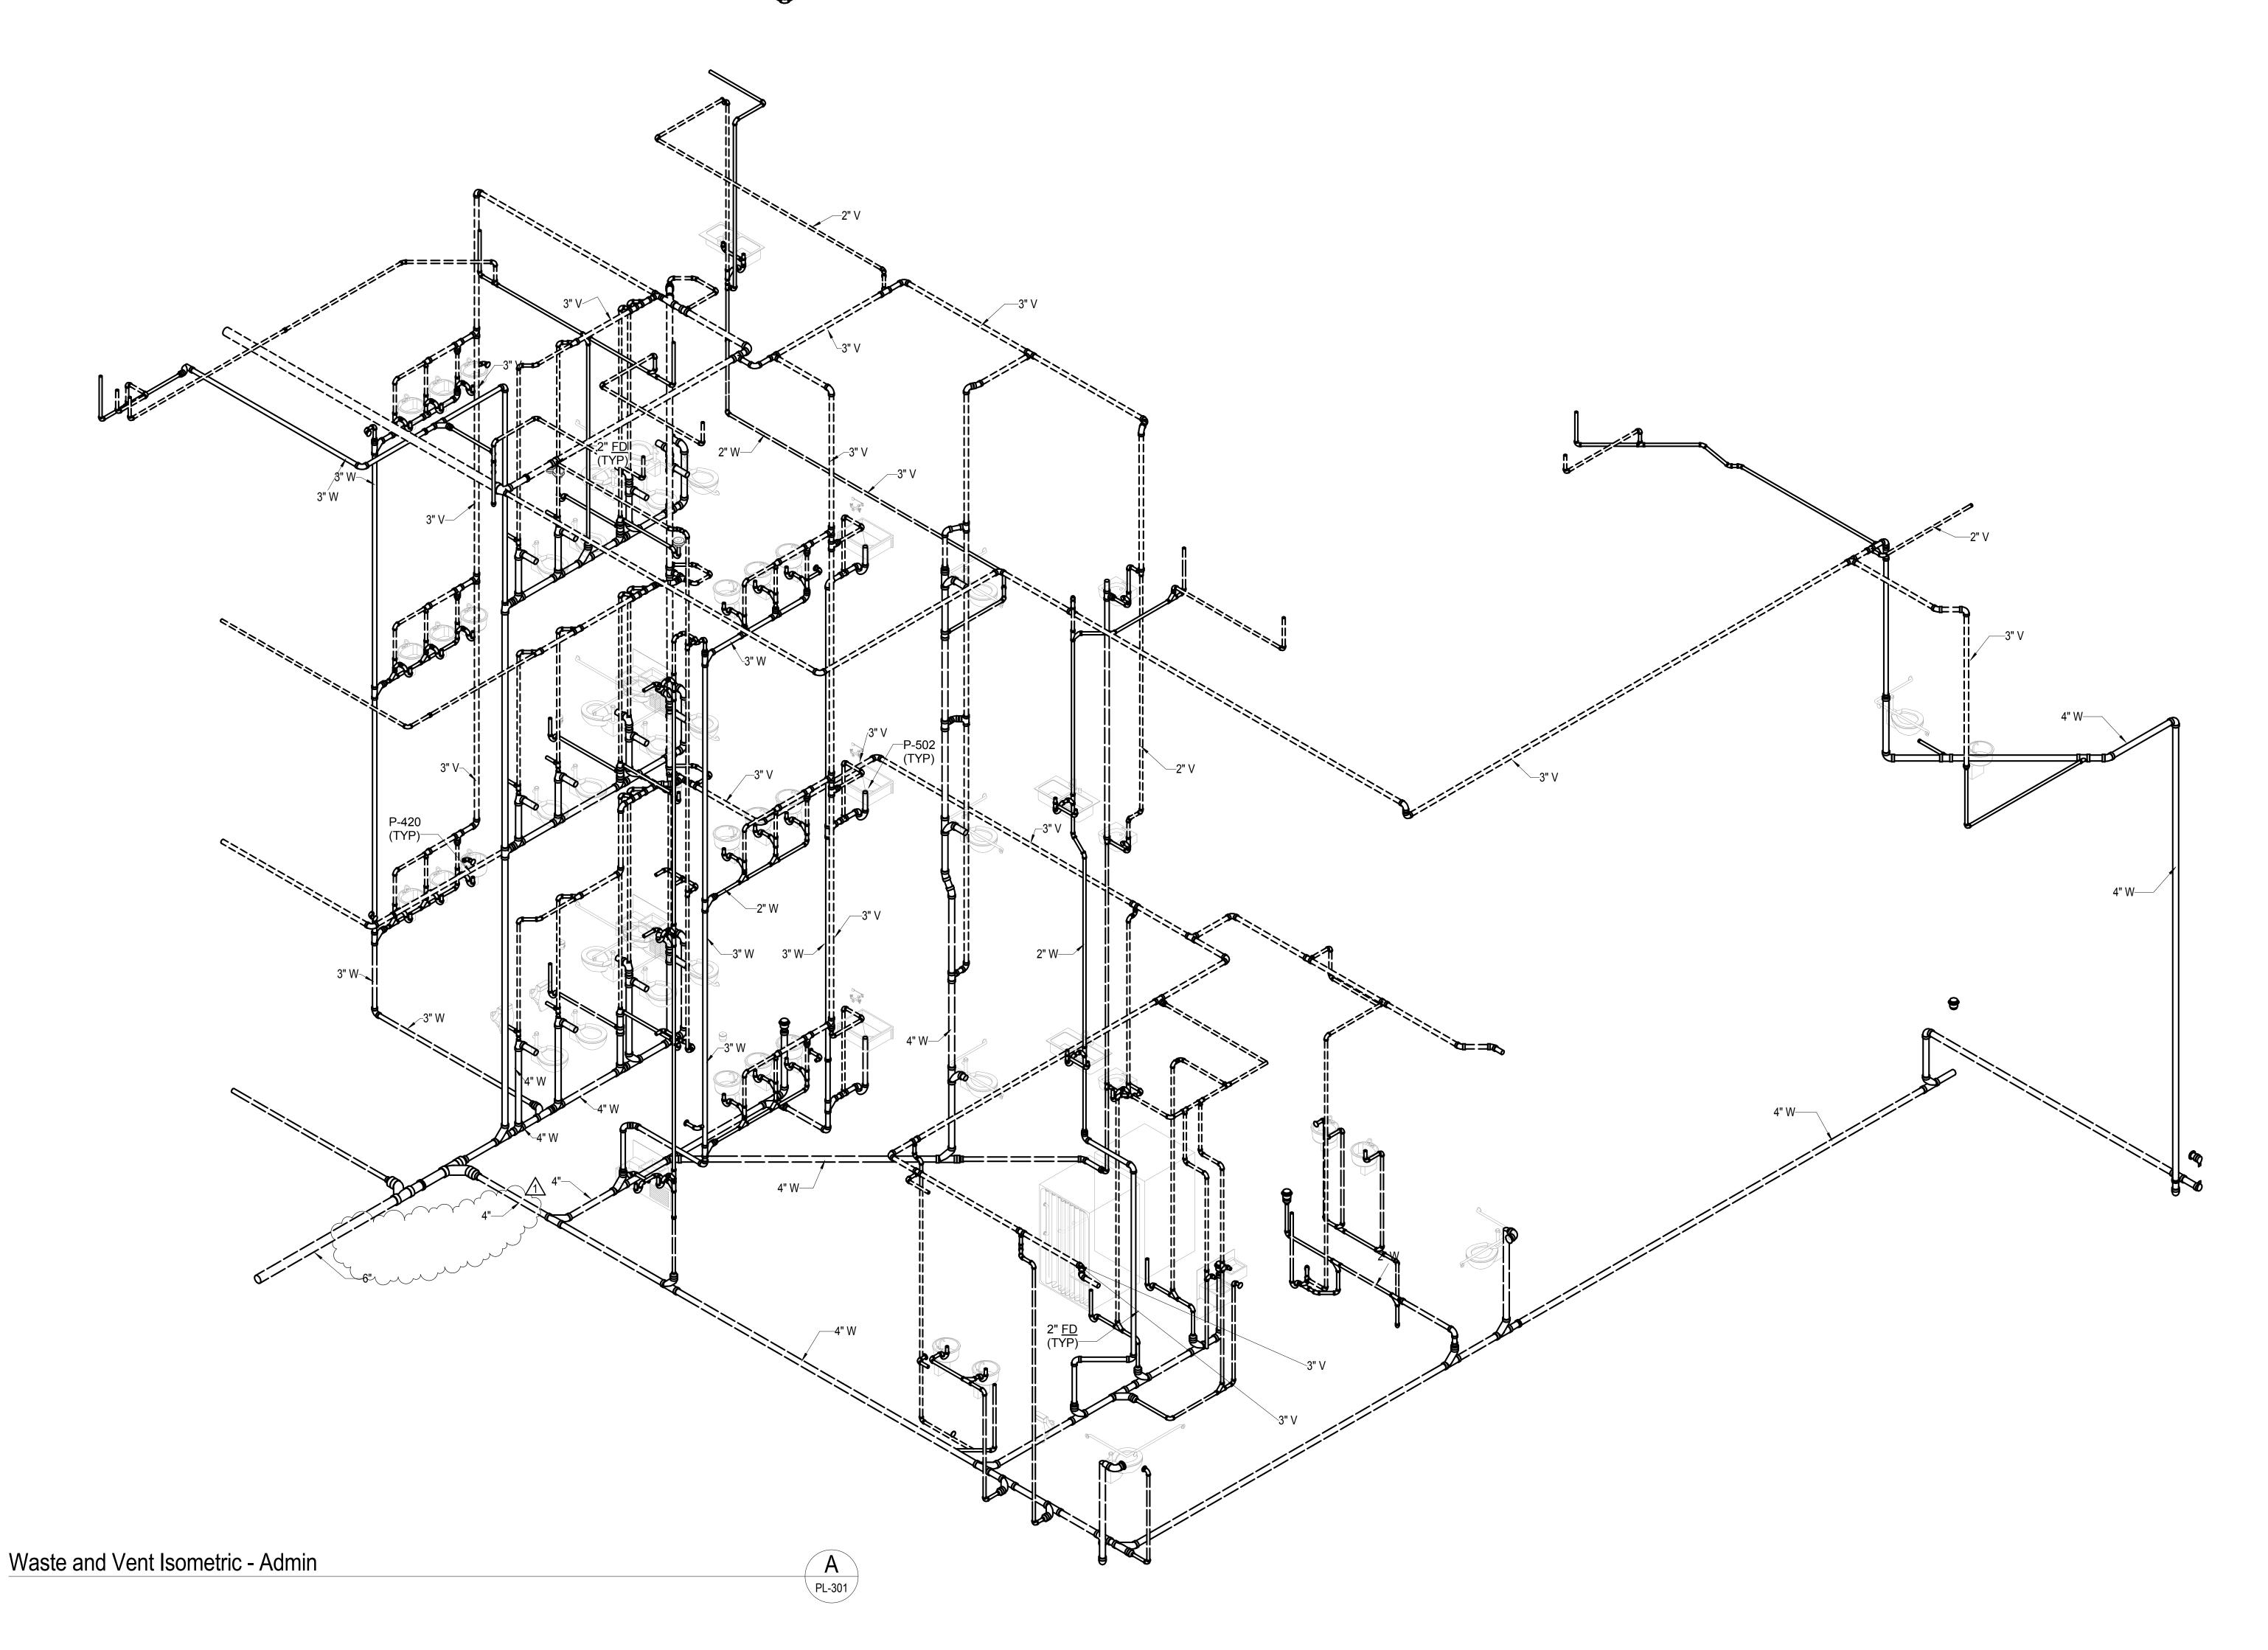

VA FORM 08-6231

### CONSTRUCTION DOCUMENTS

# BUILDING IS FULLY SPRINKLERED


1 ADDENDUM 1	08/15/12	CONSULTANTS:	KEY PLAN	ARCHITECT/ENGINEERS:	Drawing Title Waste and Vent Isometric - Admin	Project Title  VA Medical Center - PHASE	Project Number 593CA2202	Office of
		CIVIL: SLATER HANIFAN GROUP, 5740 S. ARVILLE ST. #216, LAS VEGAS, NV 8910 LANDSCAPE: J W ZUNINO LANDSCAPE ARCHITECTURE, 3191 S. JONES BLVD., LAS VEGAS MEP: JBA CONSULTING ENGINEERING, 5155 WEST PATRICK LANE, LAS VEGAS	GAS, NV 89146	RTKL	Scale	V, Administration Bldg. & Education Ctr. Addition	Building Number  6	Construction and
		STRUCTURAL:  GEOTECHNICAL:  FIRE & LIFE SAFETY:  DEGENKOLB ENGINEERING, 235 MONTGOMERY STREET, SUITE 500, SAN NINYO AND MOORE, 6700 PARADISE ROAD, SUITE E, LAS VEGAS, NV 8917 LASALLE ENGINEERING, 1000 YORK ROAD, WILLOW GROVE, PA 19090	FRANSISCO CA 94104	J M A A R C H I T E C T U R E S T U D I O S	Approved: Project Director	Location North Las Vegas, NV	Drawing Number PL-301	Facilities  Management
Revisions:	Date:			A Joint Venture	Molan Arskie	June 15, 2012 Checked Drawn MTD MAD	348 of 512	Department of Veterans Affairs

 1
 3

 5

**NOTICE** 

1 PIPING ISOMETRIC FOR REFERENCE ONLY. USE FLOOR PLANS, DETAILS, SCHEMATICS AND SPECIFICATIONS FOR CONSTRUCTION.

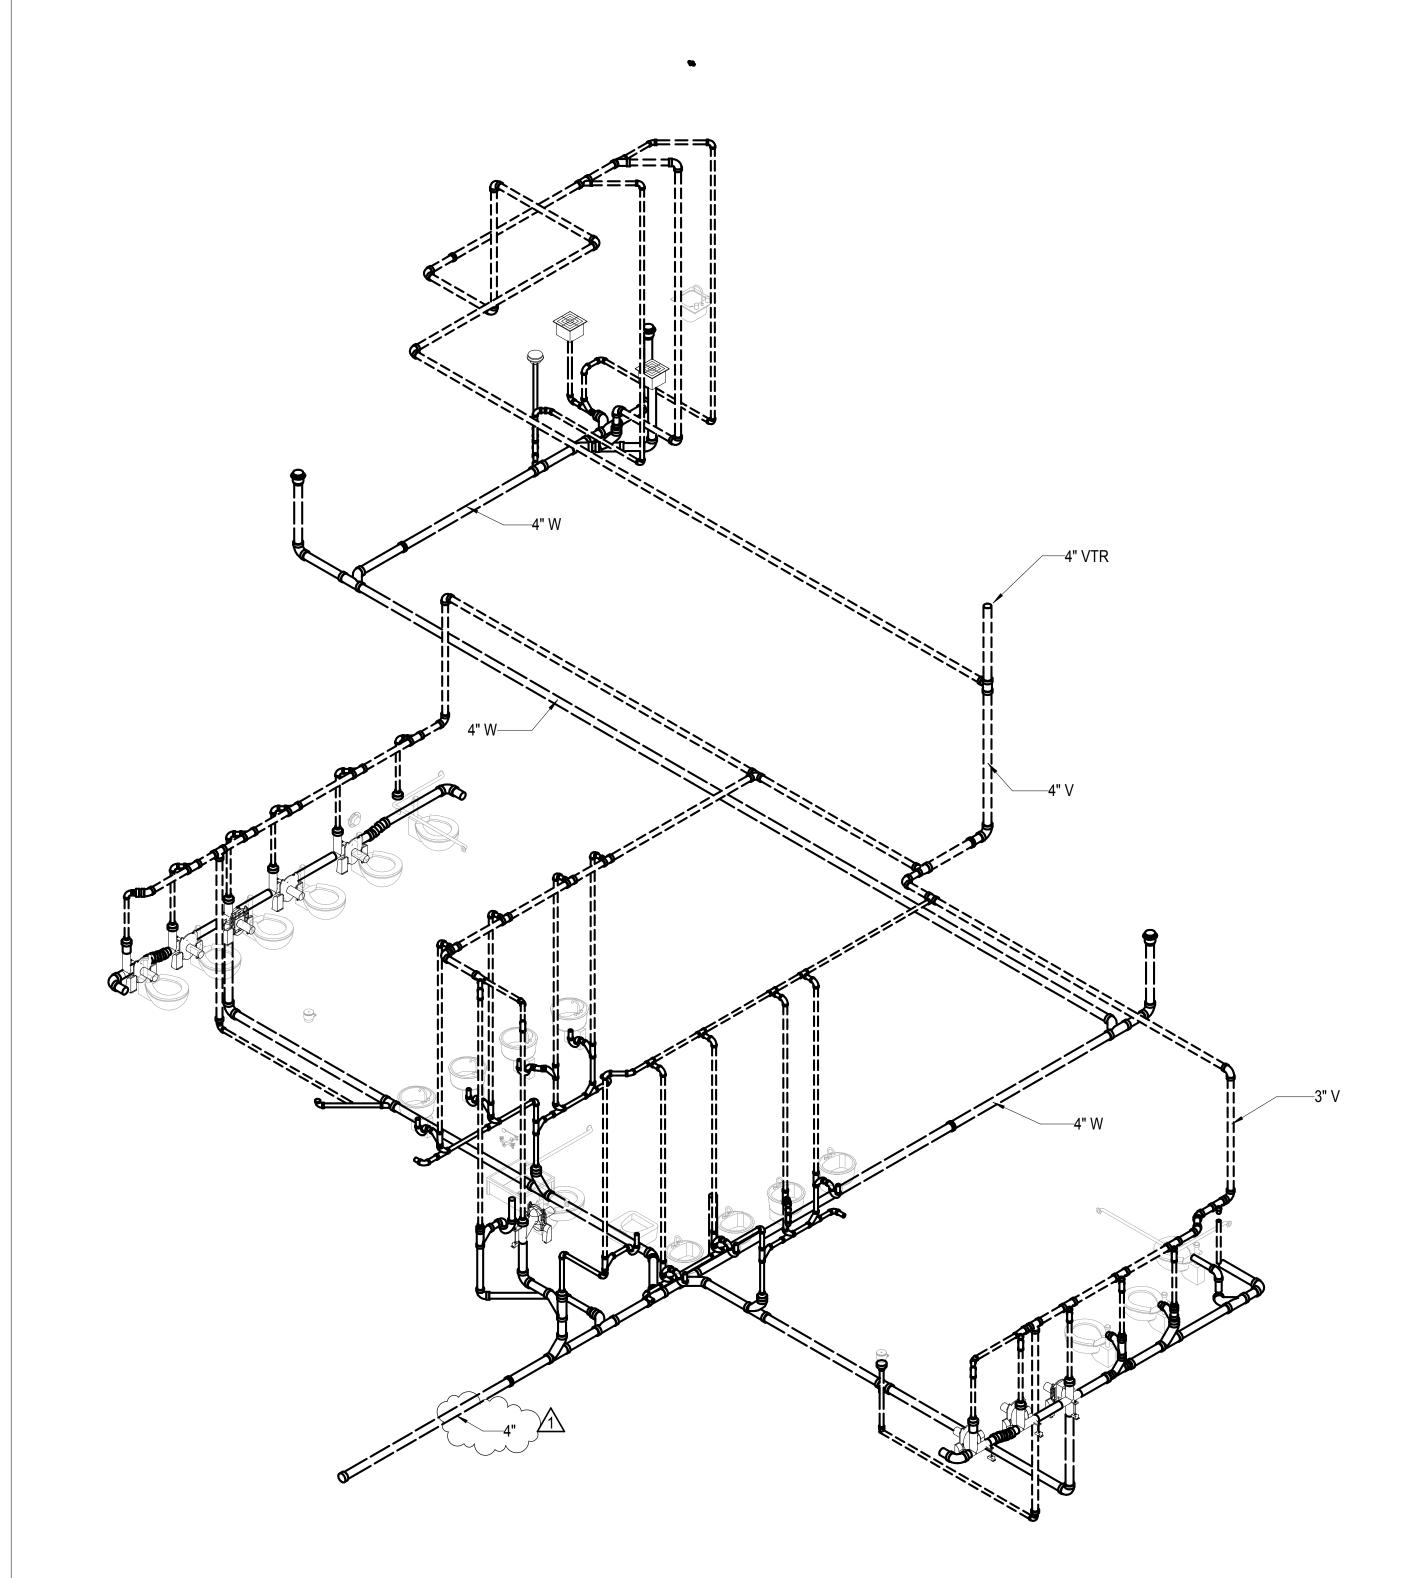

Waste and Vent Isometric - Education Center

VA FORM 08-6231

CONSTRUCTION DOCUMENTS


BUILDING IS FULLY SPRINKLERED

		KEY PLAN	ARCHITECT/ENGINEERS:	Waste and Vent Isometric - Education	VA Medical Center - PHASE	593CA2202	Office of
CIVIL: LANDSCAPE:	SLATER HANIFAN GROUP, 5740 S. ARVILLE ST. #216, LAS VEGAS, NV 89118 J W ZUNINO LANDSCAPE ARCHITECTURE, 3191 S. JONES BLVD., LAS VEGAS, NV 89146 JBA CONSULTING ENGINEERING, 5155 WEST PATRICK LANE, LAS VEGAS, NV 89118		RTKL	Center	V, Administration Bldg. & Education Ctr. Addition	Building Number  6	Construction
STRUCTURAL: GEOTECHNICAL: FIRE & LIFE SAFETY:	DEGENKOLB ENGINEERING, 235 MONTGOMERY STREET, SUITE 500, SAN FRANSISCO CA 94104 NINYO AND MOORE, 6700 PARADISE ROAD, SUITE E, LAS VEGAS, NV 89119 LASALLE ENGINEERING, 1000 YORK ROAD, WILLOW GROVE, PA 19090		J M A A R C H I T E C T U R E S T U D I O S	Approved: Project Director  Milan Arshi-	Location North Las Vegas, NV	Drawing Number PL-302	Facilities Managemer

 2
 5


 5
 9

1 PL-302

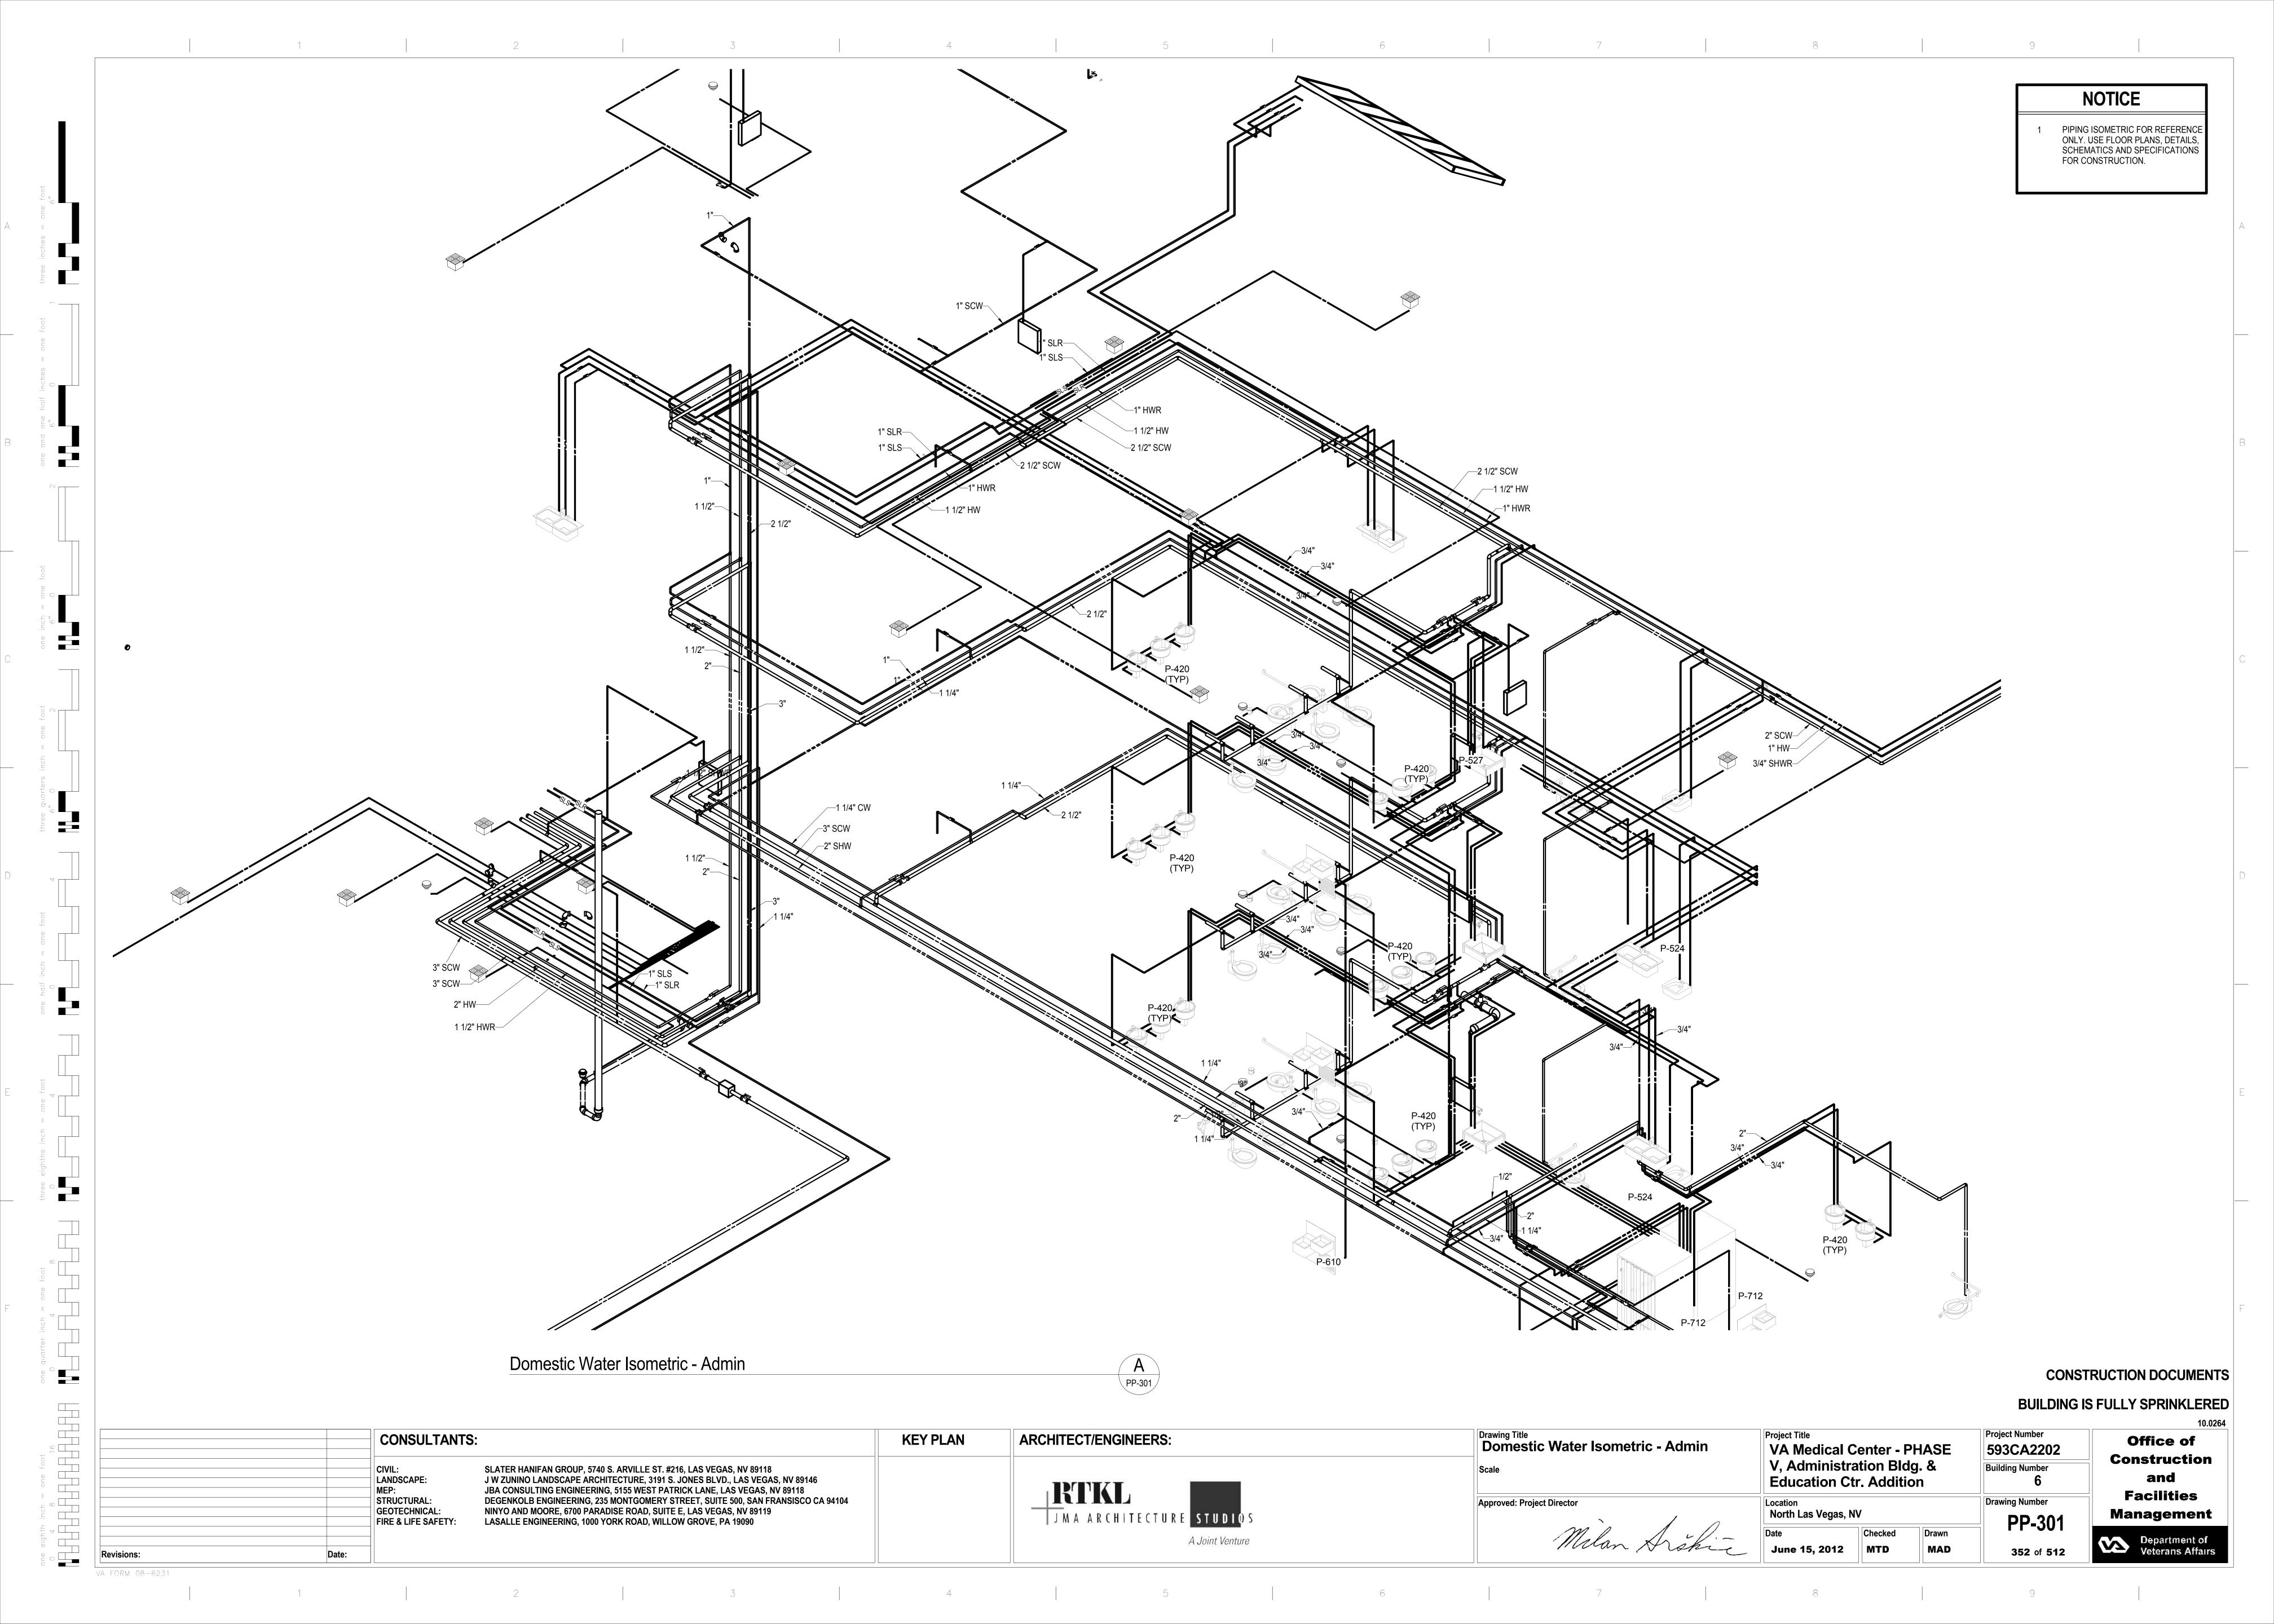


**NOTICE** 

PIPING ISOMETRIC FOR REFERENCE ONLY. USE FLOOR PLANS, DETAILS, SCHEMATICS AND SPECIFICATIONS FOR CONSTRUCTION.

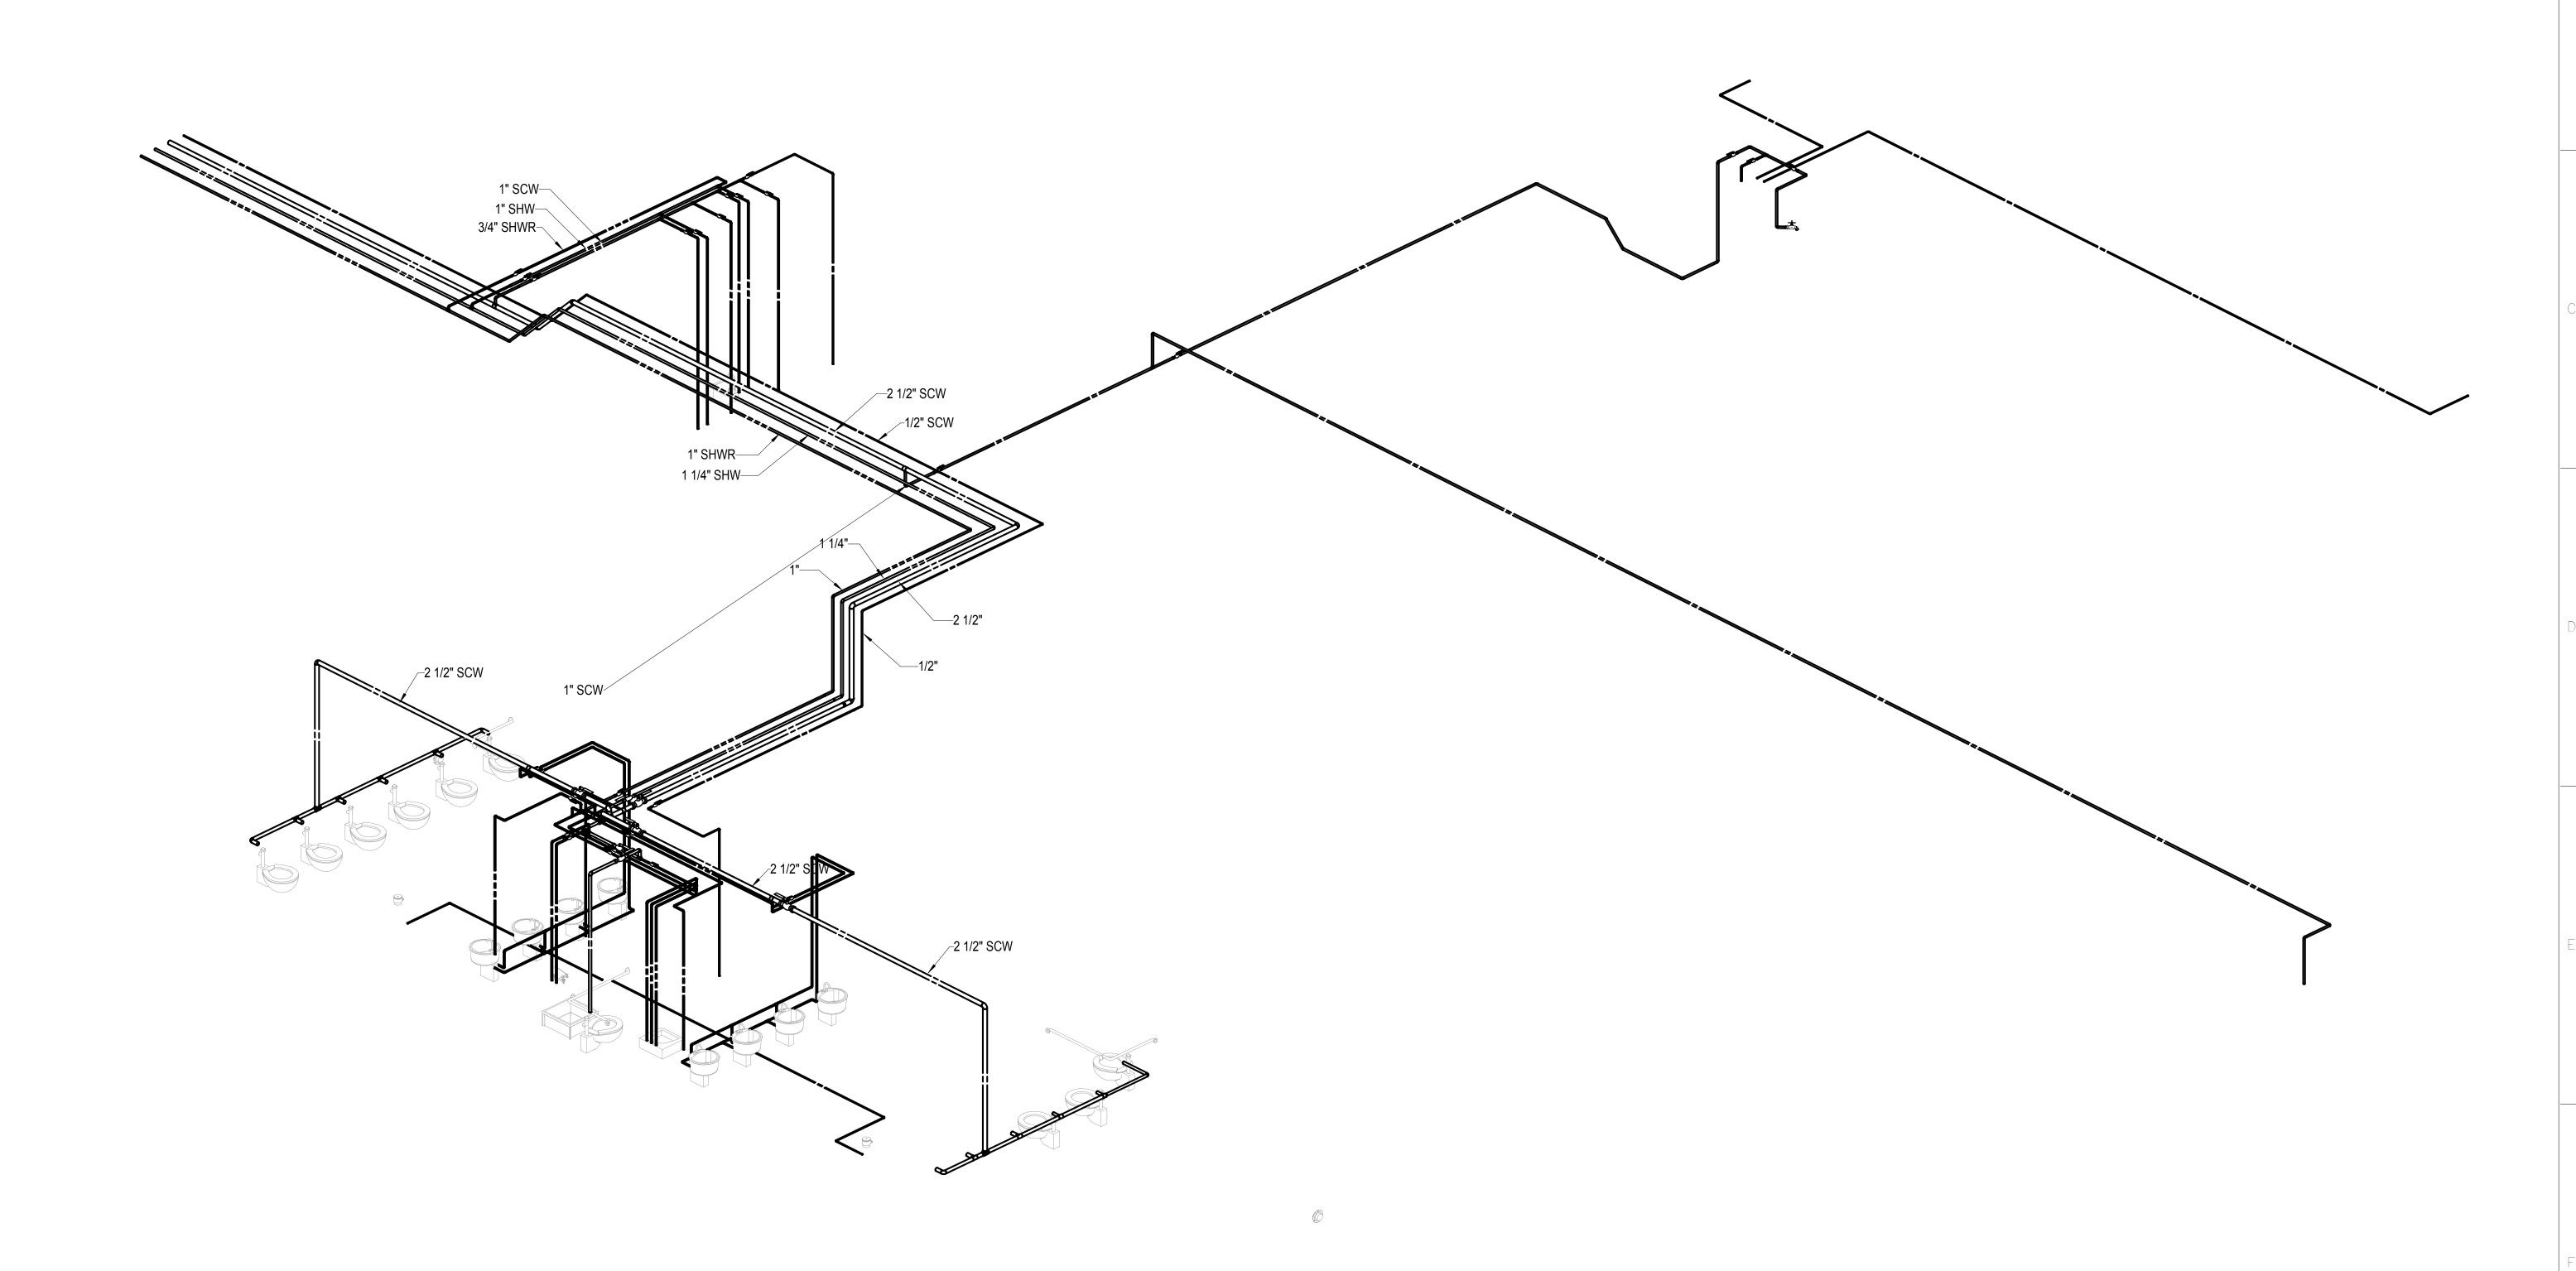

Domestic Water Isometric - Education Center

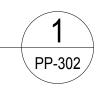


### CONSTRUCTION DOCUMENTS

# BUILDING IS FULLY SPRINKLERED

							BUILDING I	IS FULLY SPRINKLERED
CONSULTANTS:	:	KEY PLAN	ARCHITECT/ENGINEERS:	Drawing Title  Domestic Water Isometric - Education	Project Title  VA Medical Cent	er - PHASE	Project Number 593CA2202	Office of
CIVIL: LANDSCAPE: MFP·	SLATER HANIFAN GROUP, 5740 S. ARVILLE ST. #216, LAS VEGAS, NV 89118 J W ZUNINO LANDSCAPE ARCHITECTURE, 3191 S. JONES BLVD., LAS VEGAS, NV 89146 JBA CONSULTING ENGINEERING, 5155 WEST PATRICK LANE, LAS VEGAS, NV 89118			Center	V, Administration	n Bldg. &	Building Number  6	Construction
STRUCTURAL: GEOTECHNICAL: FIRE & LIFE SAFETY:	DEGENKOLB ENGINEERING, 235 MONTGOMERY STREET, SUITE 500, SAN FRANSISCO CA 94104 NINYO AND MOORE, 6700 PARADISE ROAD, SUITE E, LAS VEGAS, NV 89119 LASALLE ENGINEERING, 1000 YORK ROAD, WILLOW GROVE, PA 19090		J M A A R C H I T E C T U R E STUDIOS	Approved: Project Director	Location North Las Vegas, NV		Drawing Number PP-302	Facilities Management
evisions: Date:			A Joint Venture	Molan Arskie			353 of 512	Department of Veterans Affairs
	CIVIL: LANDSCAPE: MEP: STRUCTURAL: GEOTECHNICAL: FIRE & LIFE SAFETY:	LANDSCAPE:  MEP:  STRUCTURAL:  GEOTECHNICAL:  FIRE & LIFE SAFETY:  J W ZUNINO LANDSCAPE ARCHITECTURE, 3191 S. JÓNES BLVD., LAS VEGAS, NV 89146  JBA CONSULTING ENGINEERING, 5155 WEST PATRICK LANE, LAS VEGAS, NV 89118  DEGENKOLB ENGINEERING, 235 MONTGOMERY STREET, SUITE 500, SAN FRANSISCO CA 94104  NINYO AND MOORE, 6700 PARADISE ROAD, SUITE E, LAS VEGAS, NV 89119  FIRE & LIFE SAFETY:  LASALLE ENGINEERING, 1000 YORK ROAD, WILLOW GROVE, PA 19090	CIVIL: SLATER HANIFAN GROUP, 5740 S. ARVILLE ST. #216, LAS VEGAS, NV 89118  LANDSCAPE: J W ZUNINO LANDSCAPE ARCHITECTURE, 3191 S. JONES BLVD., LAS VEGAS, NV 89146  MEP: JBA CONSULTING ENGINEERING, 5155 WEST PATRICK LANE, LAS VEGAS, NV 89118  STRUCTURAL: DEGENKOLB ENGINEERING, 235 MONTGOMERY STREET, SUITE 500, SAN FRANSISCO CA 94104  GEOTECHNICAL: NINYO AND MOORE, 6700 PARADISE ROAD, SUITE E, LAS VEGAS, NV 89119  FIRE & LIFE SAFETY: LASALLE ENGINEERING, 1000 YORK ROAD, WILLOW GROVE, PA 19090	CIVIL:  SLATER HANIFAN GROUP, 5740 S. ARVILLE ST. #216, LAS VEGAS, NV 89118  LANDSCAPE:  J W ZUNINO LANDSCAPE ARCHITECTURE, 3191 S. JONES BLVD., LAS VEGAS, NV 89146  MEP:  JBA CONSULTING ENGINEERING, 5155 WEST PATRICK LANE, LAS VEGAS, NV 89118  STRUCTURAL:  DEGENKOLB ENGINEERING, 235 MONTGOMERY STREET, SUITE 500, SAN FRANSISCO CA 94104  NINYO AND MOORE, 6700 PARADISE ROAD, SUITE E, LAS VEGAS, NV 89119  FIRE & LIFE SAFETY:  LASALLE ENGINEERING, 1000 YORK ROAD, WILLOW GROVE, PA 19090  A Joint Venture	CONSULTANTS.  CIVIL: LANDSCAPE: JA ZUNINO LANDSCAPE ARCHITECTURE, 3191 S. JONES BLVD., LAS VEGAS, NV 89118 JBA CONSULTING ENGINEERING, 251 MONITOMERY STREET, SUITE 500, SAN FRANSISCO CA 94104 MEP: JBA CONSULTING ENGINEERING, 255 MONITOMERY STREET, SUITE 500, SAN FRANSISCO CA 94104 NINYO AND MOORE, 6700 PARADISE ROAD, SUITE E, LAS VEGAS, NV 89119  Approved: Project Director  ARCHITECTIENGINEERS.  Domestic Water Isometric - Education Center  STRUCTURAL: GEOTECHNICAL: NINYO AND MOORE, 6700 PARADISE ROAD, SUITE E, LAS VEGAS, NV 89119 LASALLE ENGINEERING, 1000 YORK ROAD, WILLOW GROVE, PA 19090  APPROVED  ARCHITECTIENGINEERS.  Domestic Water Isometric - Education Center  STRUCTURAL: STRU	CONSULTANTS.  CIVIL: LANDSCAPE: LANDSCAPE: JW ZUNINO LANDSCAPE ARCHITECTURE, 3191 S. JONES BLVD., LAS VEGAS, NV 89118 LANDSCAPE: JBA CONSULTING ENGINEERING, 3155 WEST PATRICK LANE, LAS VEGAS, NV 89118 STRUCTURAL: GEOTECHNICAL: FIRE & LIFE SAFETY:  MAA R (HITECTURE STUDIOS  ACCHITECTIVE	CONSOLITAVIS.  CIVIL: LANDSCAPE: J W ZUNINO LANDSCAPE ARCHITECTURE, 3191 S. JONES BLVD., LAS VEGAS, NV 89118 LANDSCAPE: JBA CONSULTING ENGINEERING, 5155 WEST PATRICK LANE, LAS VEGAS, NV 89146 STRUCTURAL: GEOTECHNICAL: NINYO AND MOORE, 6700 PARADISE ROAD, SUITE E, LAS VEGAS, NV 89119 LASALLE ENGINEERING, 1000 YORK ROAD, WILLOW GROVE, PA 19090  Checked Date  ARCHITECTIENSINEERS.  Domestic Water Isometric - Education VA Medical Center - PHASE V, Administration Bldg. & Education Ctr. Addition  Approved: Project Director  NINYO AND MOORE, 6700 PARADISE ROAD, SUITE E, LAS VEGAS, NV 89119  LASALLE ENGINEERING, 1000 YORK ROAD, WILLOW GROVE, PA 19090  Checked Date Landscape: J M A A R ( H   T E ( T U R E ST U D I ) S  A Joint Venture  Checked Drawn Lune 15 2012  Checked Ch	CONSULTANTS:  CIVIL: LANDSCAPE: LANDSCAPE: LANDSCAPE: STRUCTURAL: GEOTECHNICAL: FIRE 8 LIFE SAFETY:  CONSULTINAN GROUP, 5740 S. ARVILLE ST. #216, LAS VEGAS, NV 89118 BLOCASION CAPACIDES  CIVIL: LANDSCAPE: LANDSCAPE: JUNE 23 MONTGOMERY STREET, SUITE 90, SAN FRANSISCO CA 94104 MEDICAL: FIRE 8 LIFE SAFETY:  Approved: Project Director  CONSULTINAN GROUP, 5740 S. ARVILLE ST. #216, LAS VEGAS, NV 89118 SUITINAN GROUP, 5740 S. ARVILLE ST.


 1
 5

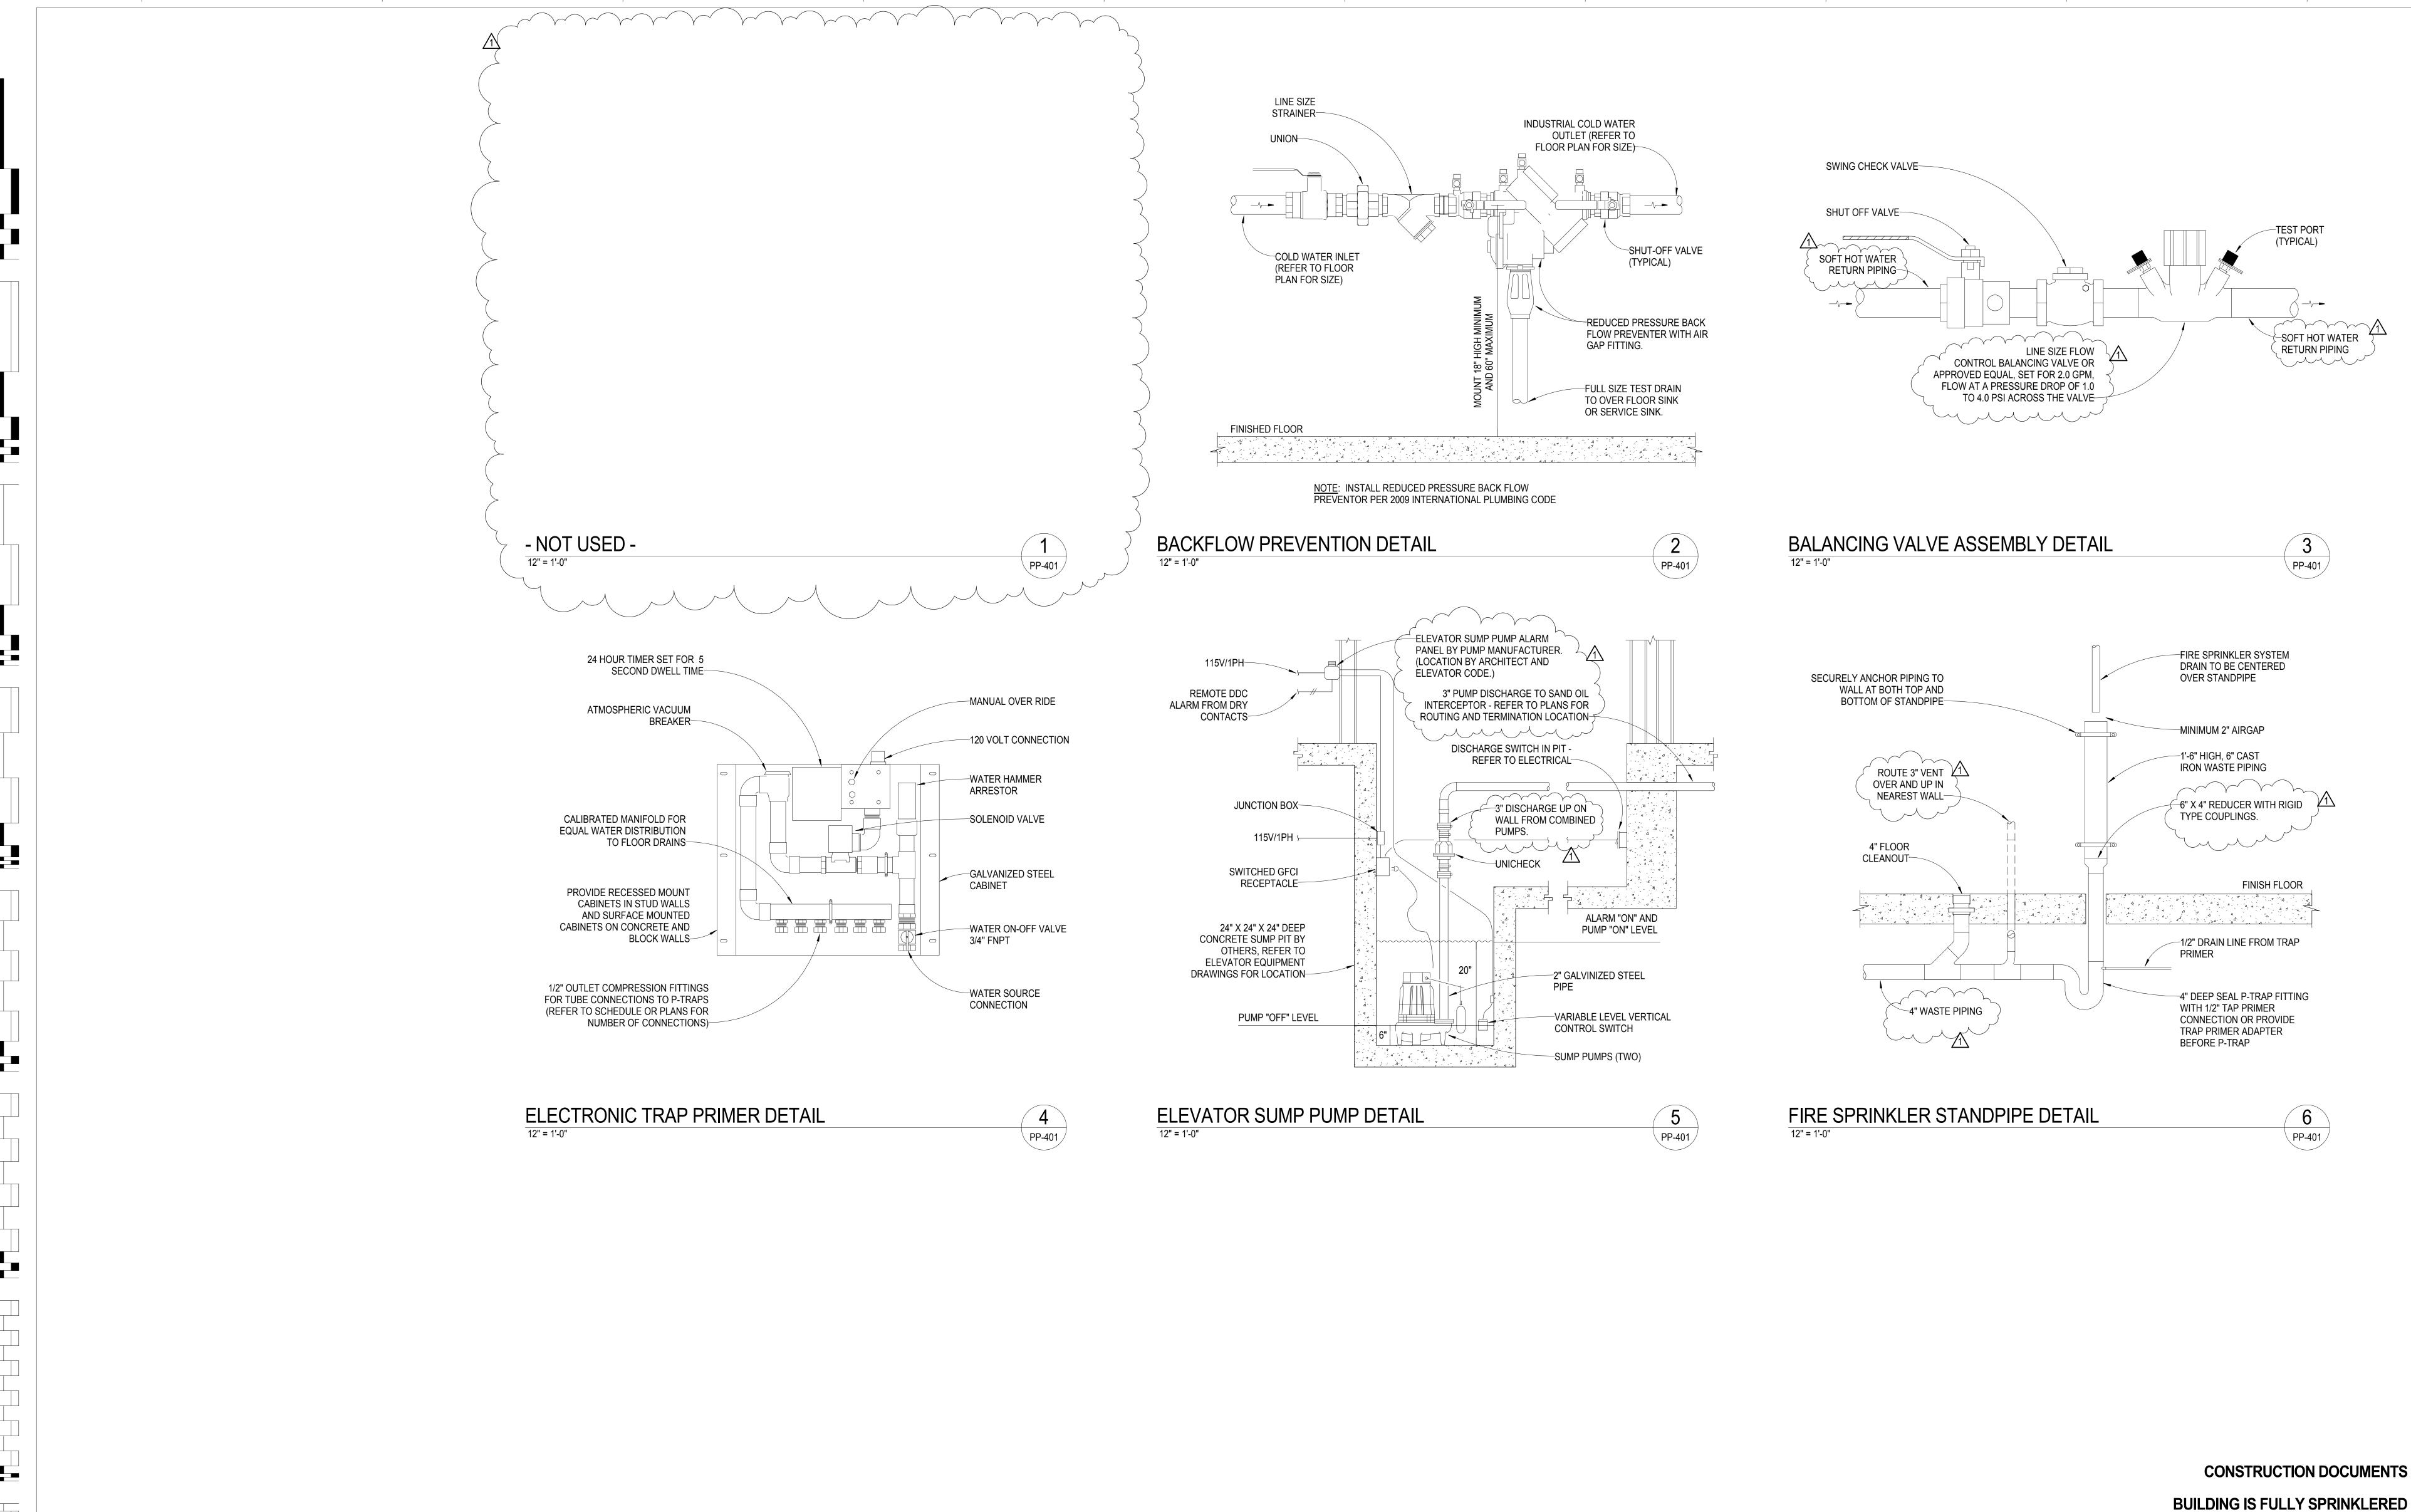

1 ADDENDUM 1 08/1	CONSULTANT	S:	KEY PLAN	ARCHITECT/ENGINEERS:	Drawing Title Plumbing - Details	Project Title  VA Medical Center - PHASE	Project Number 593CA2202	Office of
	CIVIL: LANDSCAPE: MEP:	SLATER HANIFAN GROUP, 5740 S. ARVILLE ST. #216, LAS VEGAS, NV 89118 J W ZUNINO LANDSCAPE ARCHITECTURE, 3191 S. JONES BLVD., LAS VEGAS, NV 89146 JBA CONSULTING ENGINEERING, 5155 WEST PATRICK LANE, LAS VEGAS, NV 89118		RTKL	Scale	V, Administration Bldg. & Education Ctr. Addition	Building Number  6	Construction
	STRUCTURAL: GEOTECHNICAL: FIRE & LIFE SAFETY:	DEGENKOLB ENGINEERING, 235 MONTGOMERY STREET, SUITE 500, SAN FRANSISCO CA 94104 NINYO AND MOORE, 6700 PARADISE ROAD, SUITE E, LAS VEGAS, NV 89119 LASALLE ENGINEERING, 1000 YORK ROAD, WILLOW GROVE, PA 19090		J M A A R C H I T E C T U R E S T U D I O S	Approved: Project Director	Location North Las Vegas, NV	Drawing Number PP-401	Facilities  Management
Revisions: Date:				A Joint Venture	Molan Arshie	June 15, 2012 MTD Drawn	354 of 512	Department of Veterans Affairs

 1
 2


 3
 9

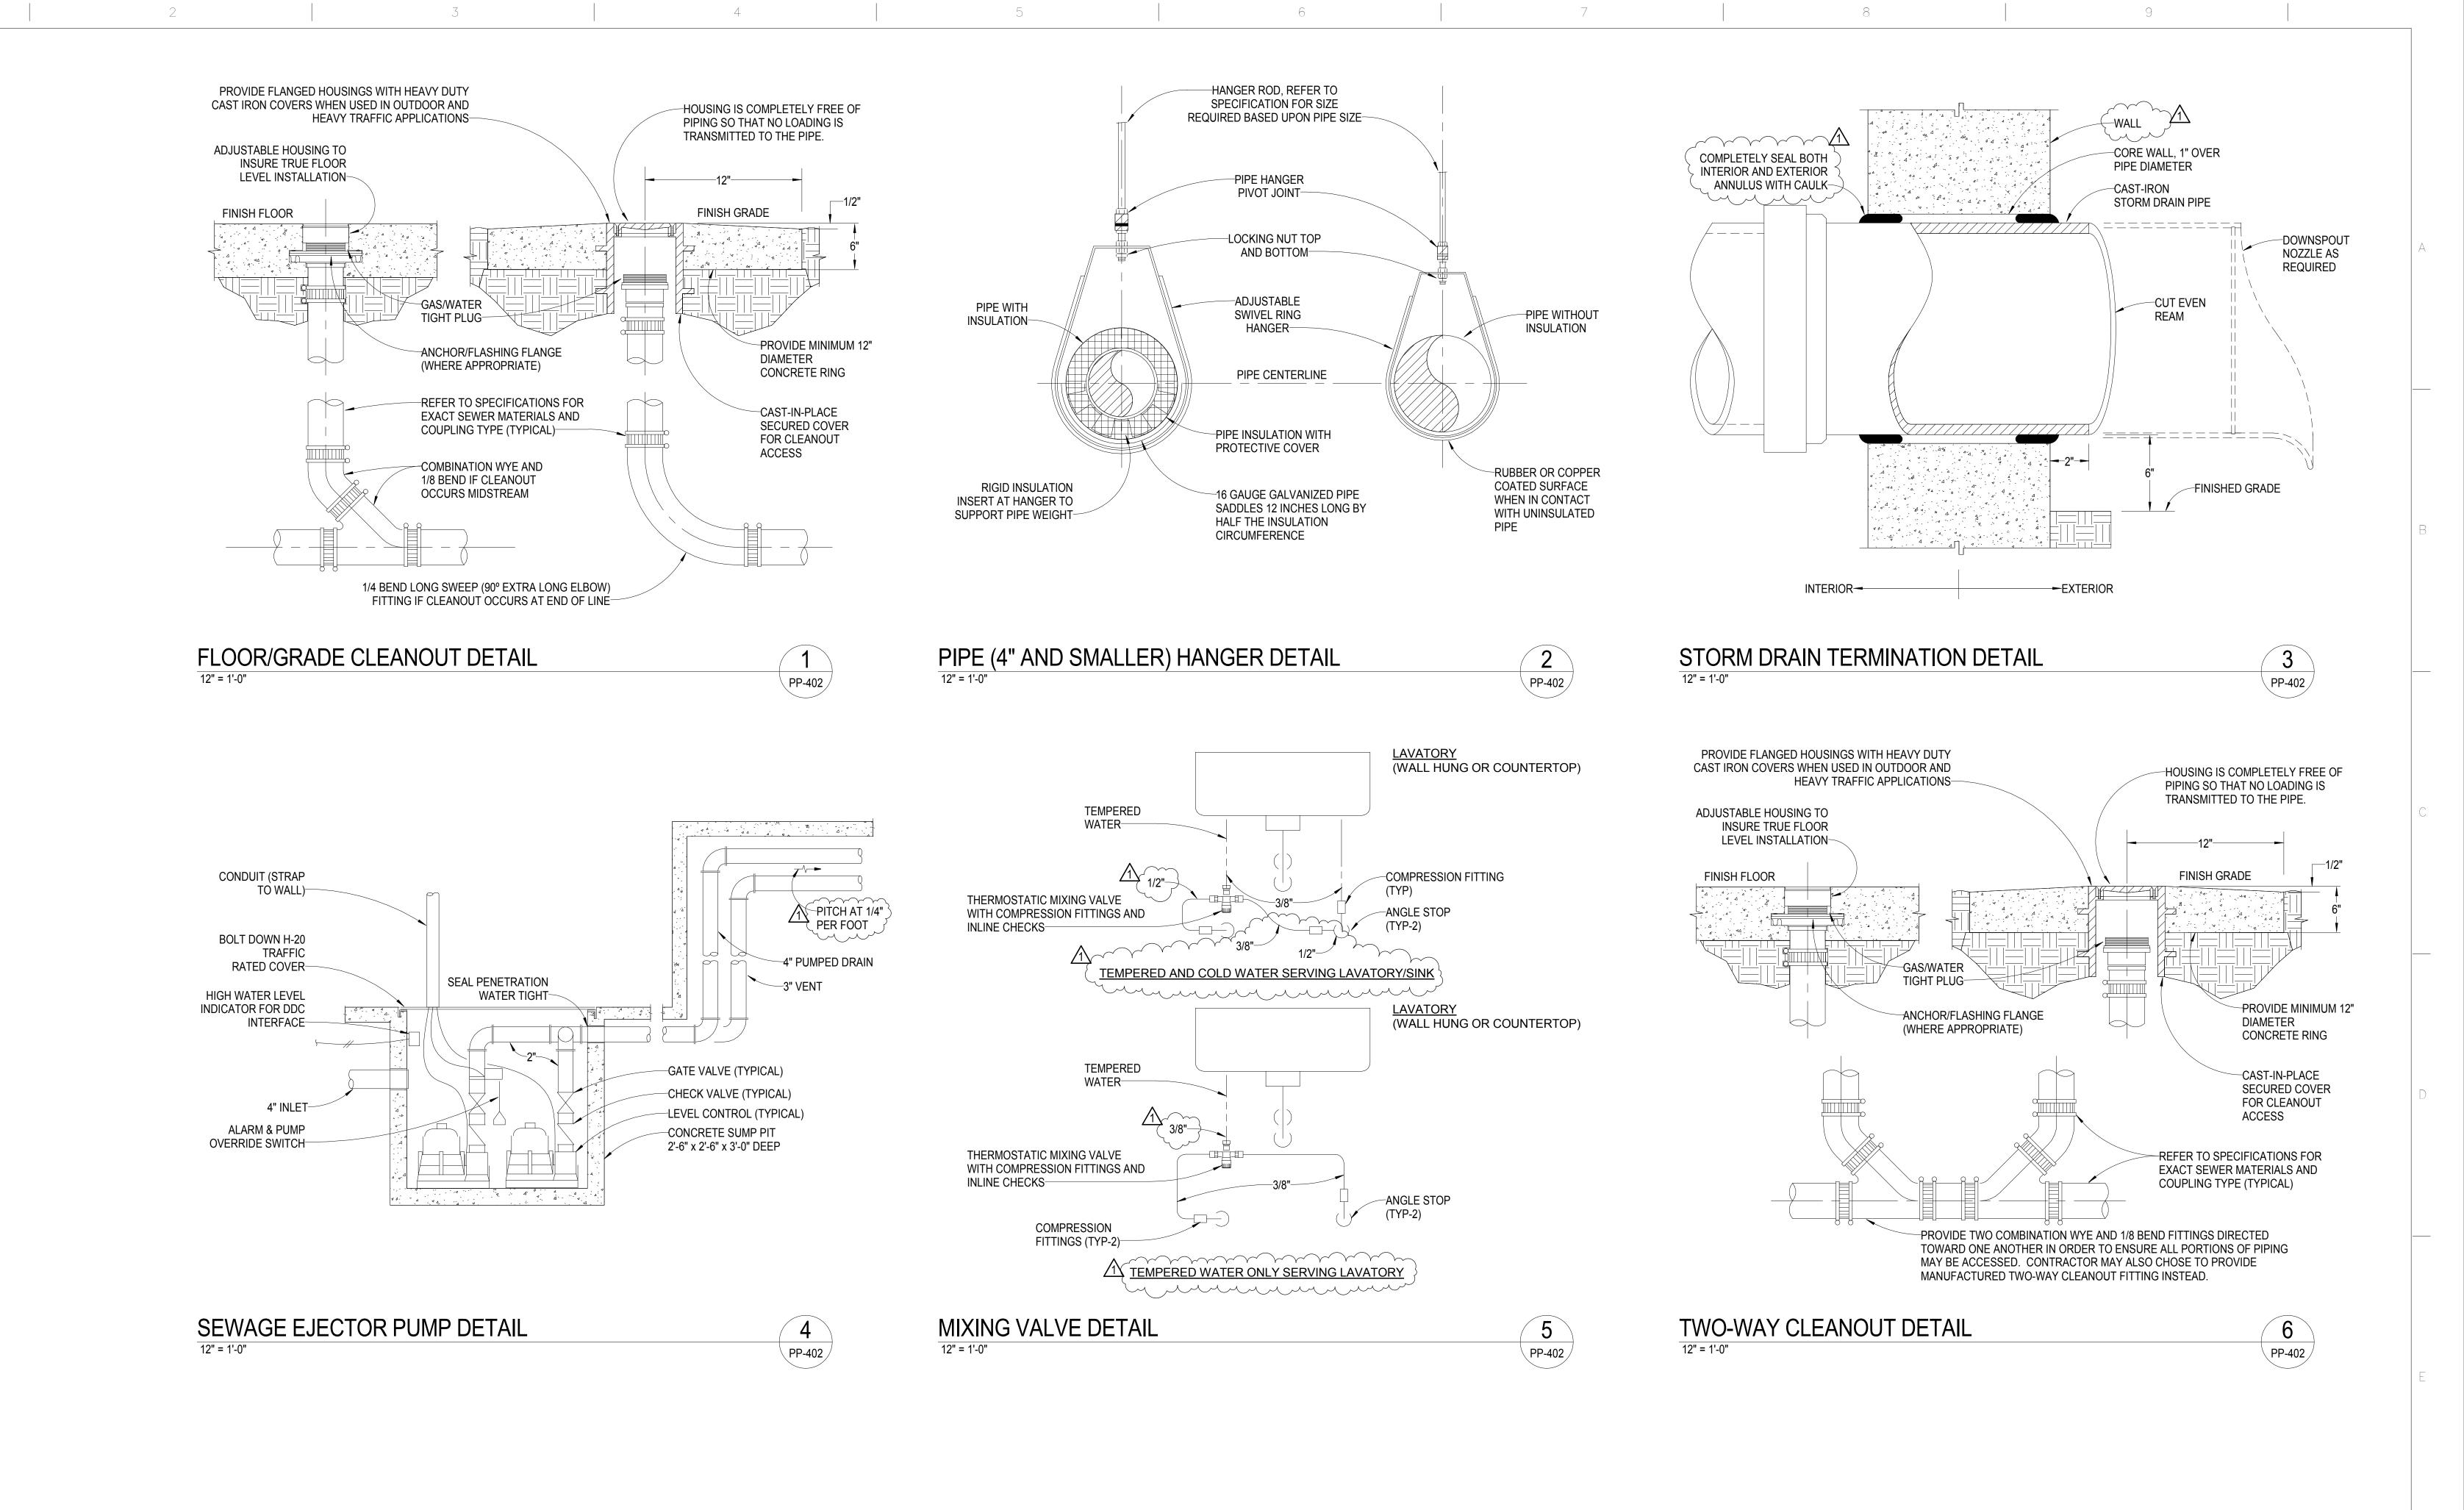

**CONSTRUCTION DOCUMENTS** 

**BUILDING IS FULLY SPRINKLERED** 

								BUILDING	S FULLY SPRINKLERED
		_							10.0264
1 9 0	1 ADDENDUM 1 08/15/12	CONSULTANT	S:	KEY PLAN	ARCHITECT/ENGINEERS:	Drawing Title Plumbing - Details	VA Medical Center - PHASE	Project Number 593CA2202	Office of
		CIVIL:	SLATER HANIFAN GROUP, 5740 S. ARVILLE ST. #216, LAS VEGAS, NV 89118			Scale	V, Administration Bldg. &	Building Number	Construction
0		LANDSCAPE:	J W ZUNINO LANDSCAPE ARCHITECTURE, 3191 S. JONES BLVD., LAS VEGAS, NV 89146 JBA CONSULTING ENGINEERING, 5155 WEST PATRICK LANE, LAS VEGAS, NV 89118		RTKL		Education Ctr. Addition	6	and
ς ω <u>Γ</u>		STRUCTURAL: GEOTECHNICAL:	DEGENKOLB ENGINEERING, 235 MONTGOMERY STREET, SUITE 500, SAN FRANSISCO CA 94104 NINYO AND MOORE, 6700 PARADISE ROAD, SUITE E, LAS VEGAS, NV 89119			Approved: Project Director	Location North Las Vegas, NV	Drawing Number	Facilities Management
÷ 4 —		FIRE & LIFE SAFETY:	LASALLE ENGINEERING, 1000 YORK ROAD, WILLOW GROVE, PA 19090		J M A A R C H I T E C T U R E STUDIOS	min = 1		PP-402	Management
.0					A Joint Venture	Milan Arskin	June 15, 2012 MTD MAD	355 of 512	Department of Veterans Affairs
	Revisions: Date:							355 0 512	Veteralis Alialis

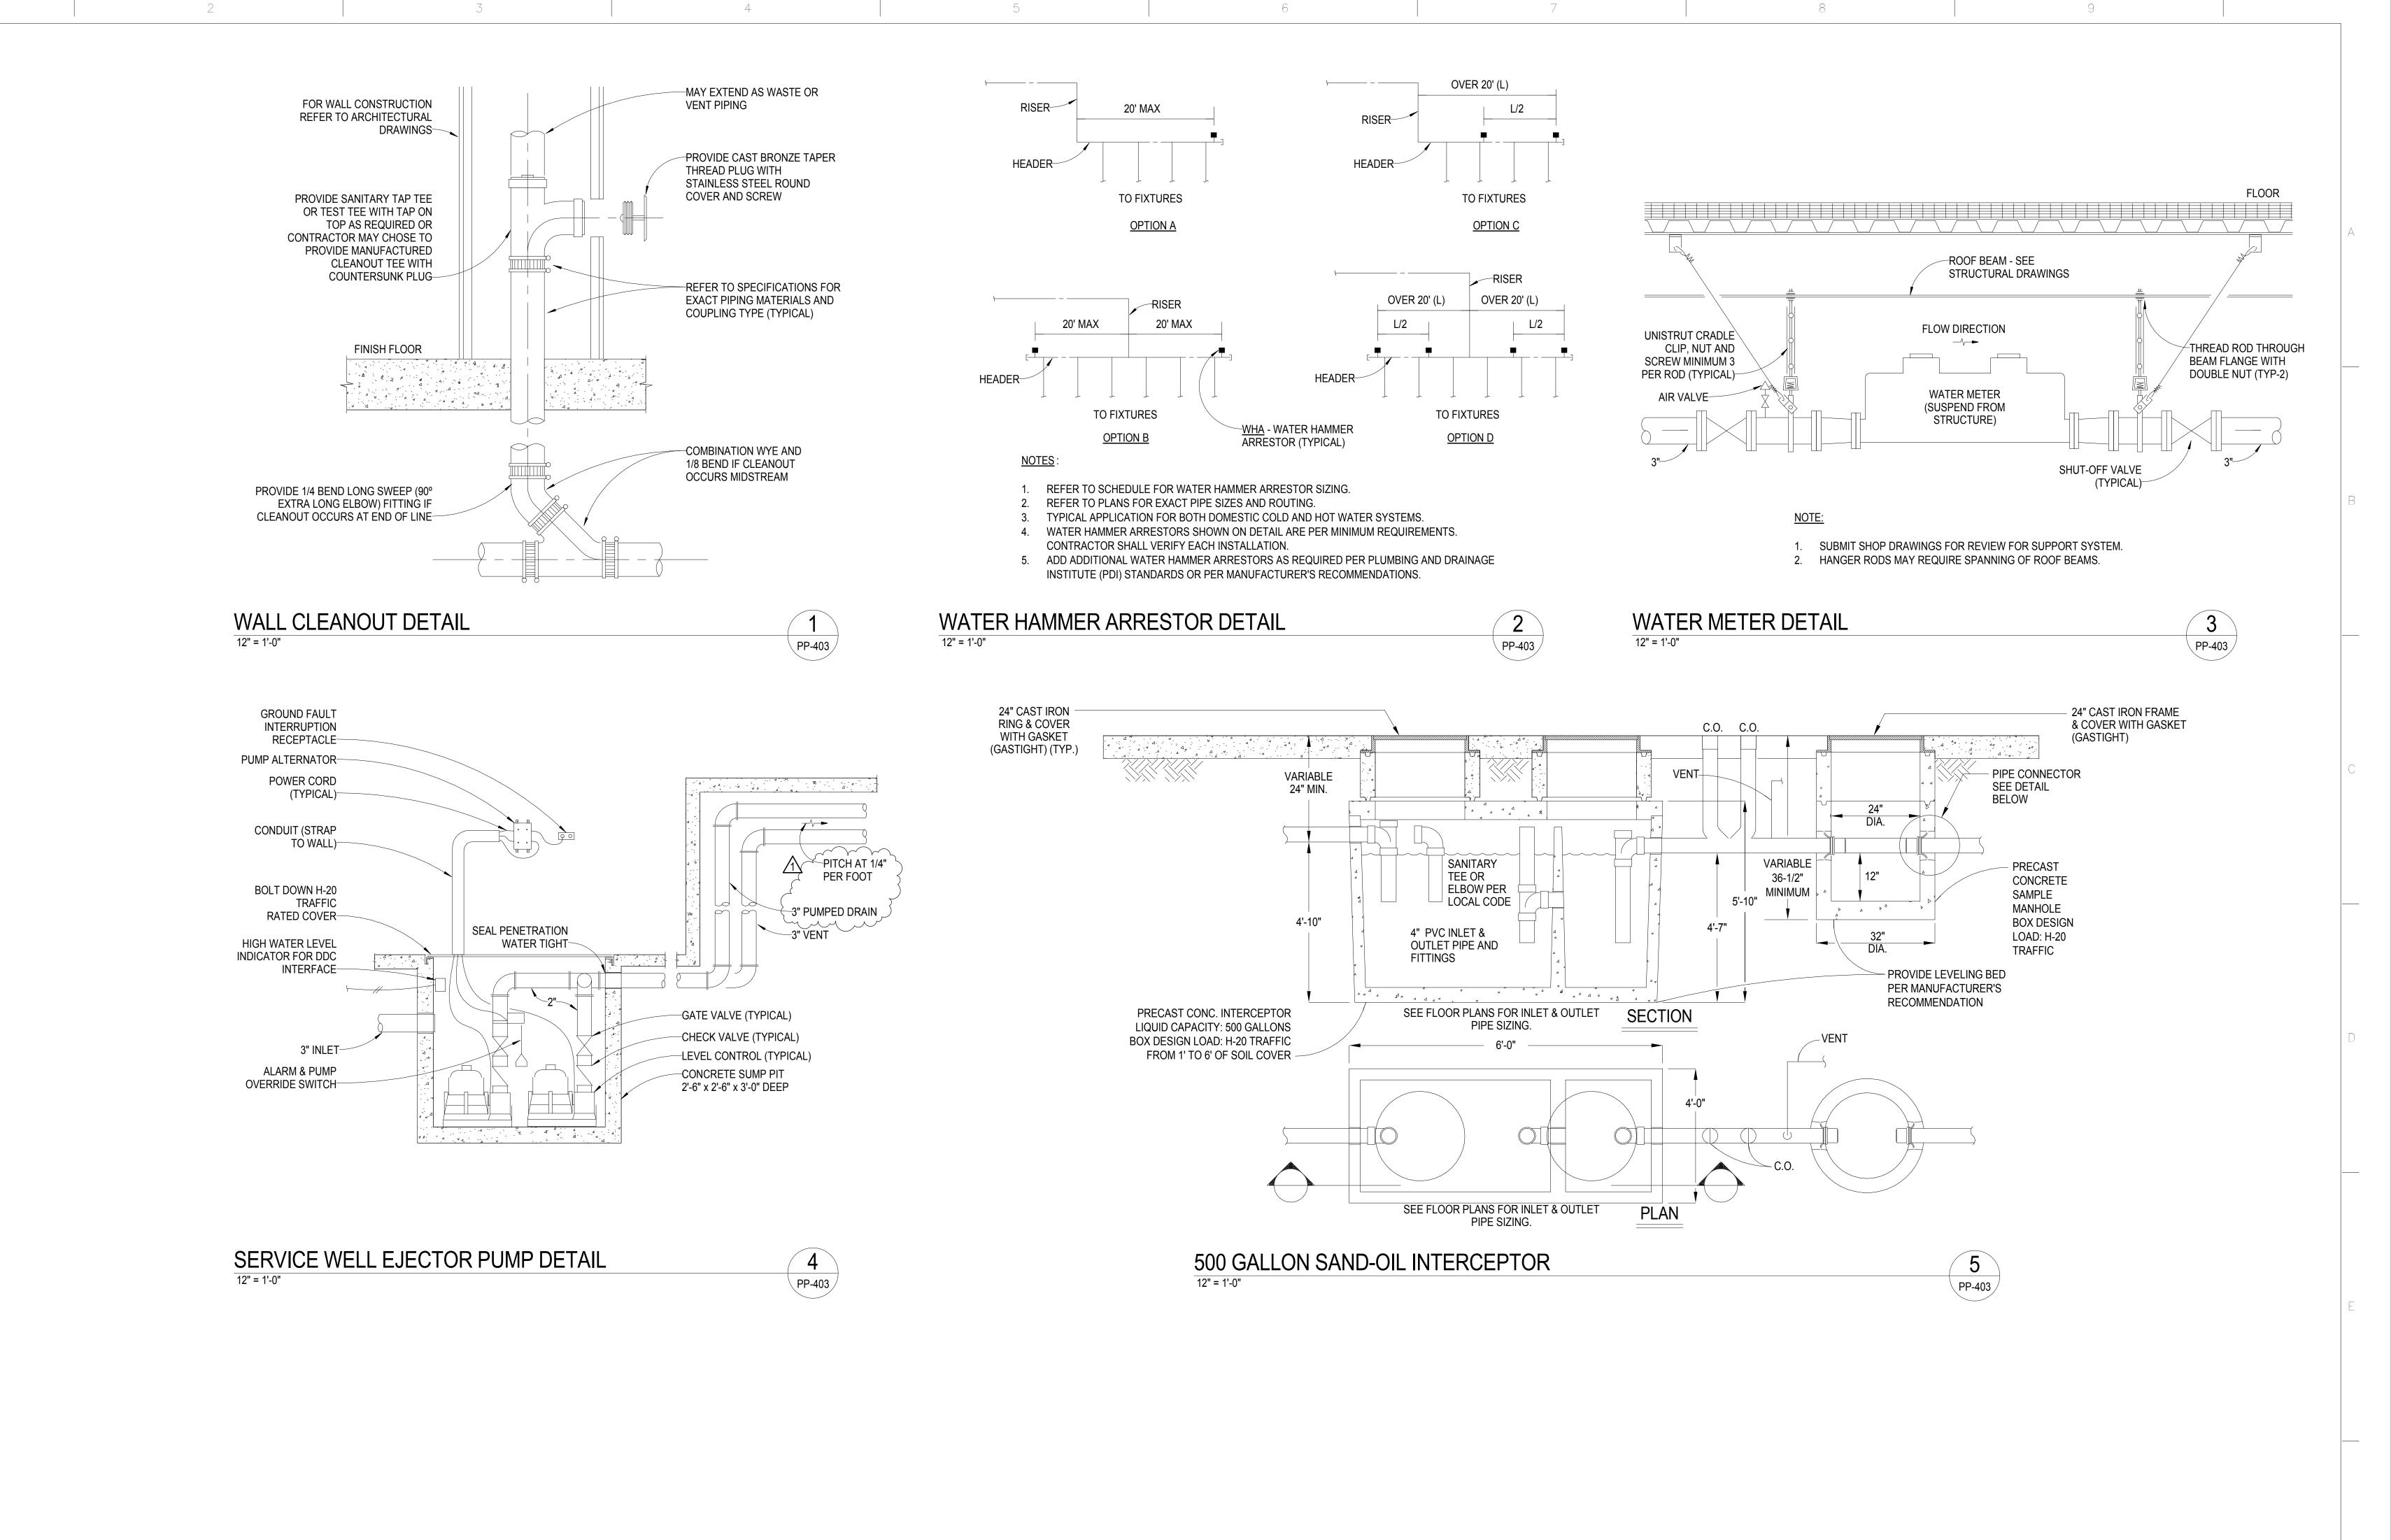



#### CONSTRUCTION DOCUMENTS


## BUILDING IS FULLY SPRINKLERED

1 ADDENDUM 1 08/15/12	CONSULTANT	S:	KEY PLAN	ARCHITECT/ENGINEERS:	Plumbing - Details	Project Title  VA Medical (	Center - Ph	HASE	Project Number 593CA2202	Office of
	CIVIL: LANDSCAPE:	SLATER HANIFAN GROUP, 5740 S. ARVILLE ST. #216, LAS VEGAS, NV 89118 J W ZUNINO LANDSCAPE ARCHITECTURE, 3191 S. JONES BLVD., LAS VEGAS, NV 89146 JBA CONSULTING ENGINEERING. 5155 WEST PATRICK LANE. LAS VEGAS. NV 89118			Scale	V, Administr Education C	_	<i>*</i>	Building Number  6	Construction
	STRUCTURAL: GEOTECHNICAL: FIRE & LIFE SAFETY:	DEGENKOLB ENGINEERING, 235 MONTGOMERY STREET, SUITE 500, SAN FRANSISCO CA 94104 NINYO AND MOORE, 6700 PARADISE ROAD, SUITE E, LAS VEGAS, NV 89119 LASALLE ENGINEERING, 1000 YORK ROAD, WILLOW GROVE, PA 19090		JMA ARCHITECTURE STUDIOS	Approved: Project Director	Location North Las Vegas, N	IV		Drawing Number PP-403	Facilities Management
Revisions: Date:				A Joint Venture	Molan Arshie	Date  June 15, 2012	Checked MTD	Drawn MAD		Department of Veterans Affairs

 2
 3
 9

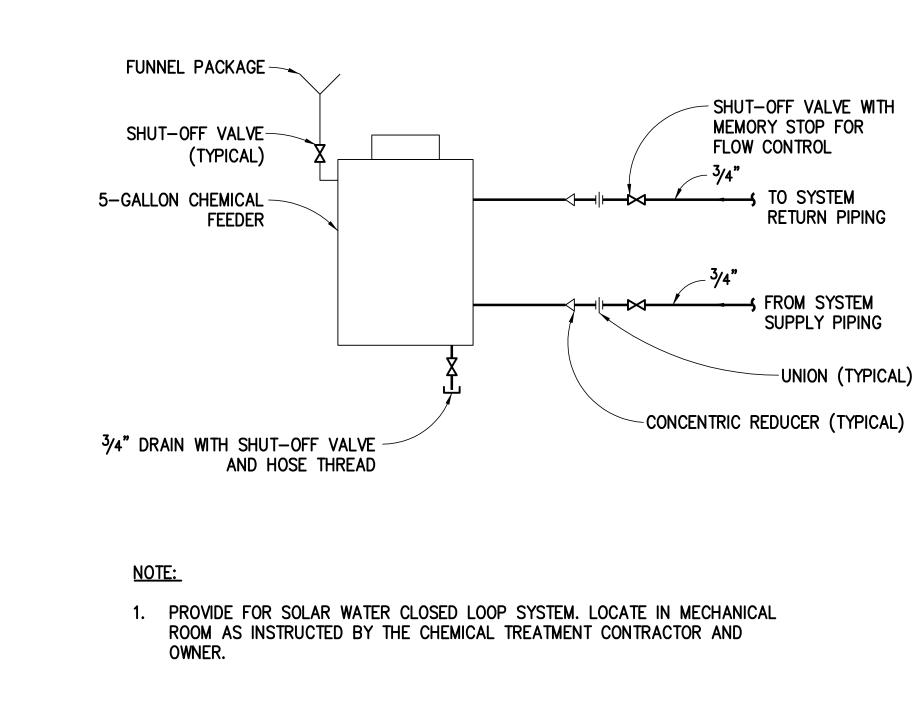

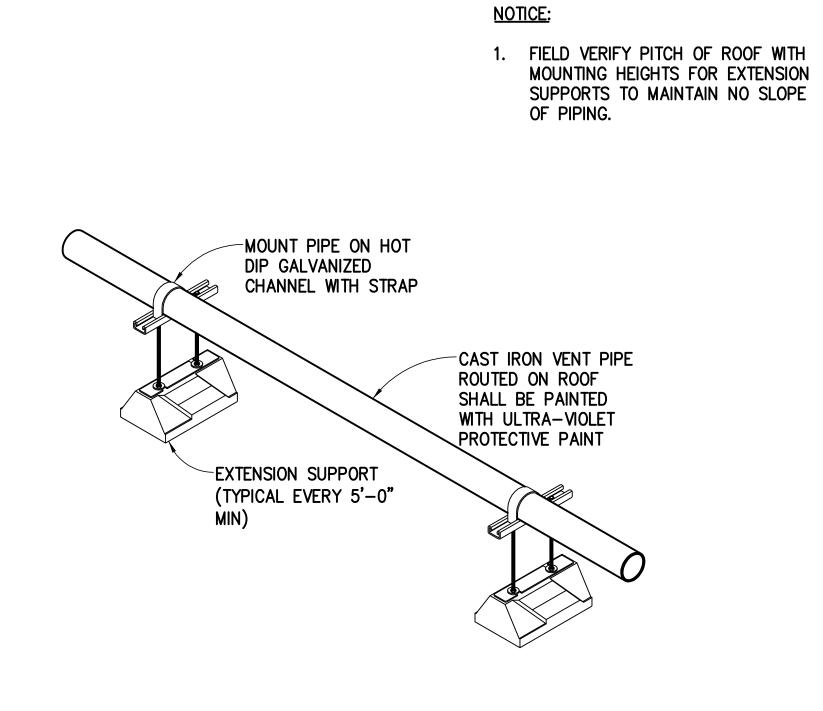

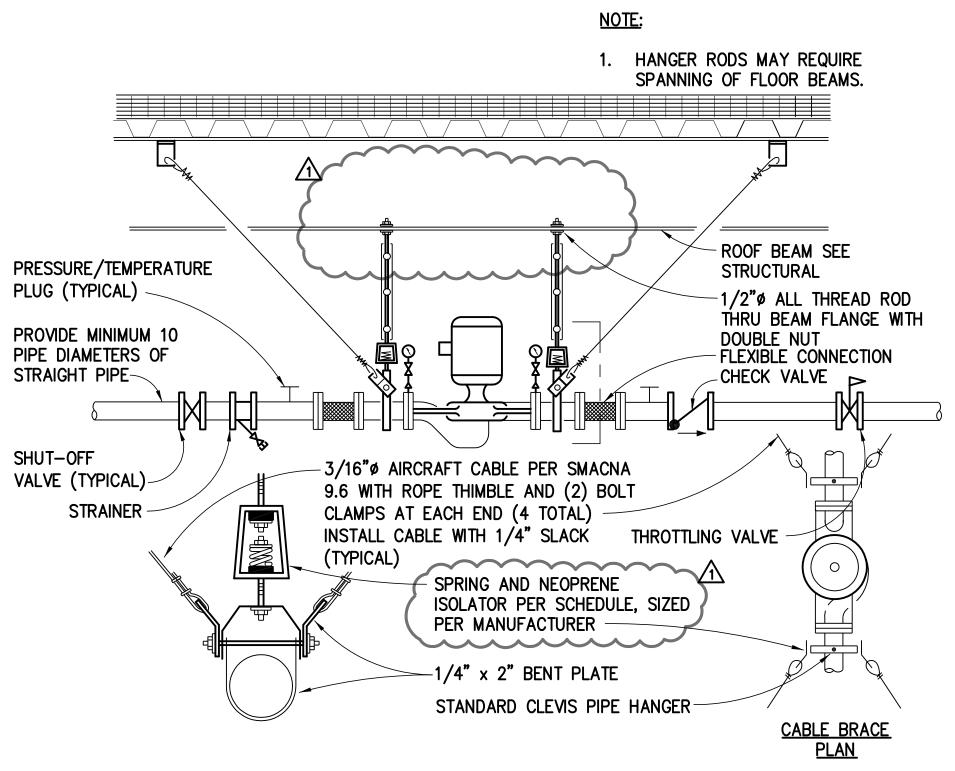

CHEMICAL FEEDER DETAIL
NO SCALE

VA FORM 08-62

**1**PP-404

ROOF MOUNTED PIPING SUPPORT DETAIL

NO SCALE

PP-404

IN-LINE PUMP DETAIL
NO SCALE

PP-404

CONSTRUCTION DOCUMENTS
BUILDING IS FULLY SPRINKLERED

8 4 8 Plumbing - Details Project Number CONSULTANTS: ADDENDUM 1 **KEY PLAN ARCHITECT/ENGINEERS:** Office of **VA Medical Center - PHASE** 593CA2202 Construction V, Administration Bldg. & **Building Number** SLATER HANIFAN GROUP, 5740 S. ARVILLE ST. #216, LAS VEGAS, NV 89118 J W ZUNINO LANDSCAPE ARCHITECTURE, 3191 S. JONES BLVD., LAS VEGAS, NV 89146 Scale N.T.S. and LANDSCAPE: **Education Ctr. Addition** RTKL JBA CONSULTING ENGINEERING, 5155 WEST PATRICK LANE, LAS VEGAS, NV 89118 **Facilities** Drawing Number STRUCTURAL: DEGENKOLB ENGINEERING, 235 MONTGOMERY STREET, SUITE 500, SAN FRANSISCO CA 94104 Approved: Project Director North Las Vegas, NV **GEOTECHNICAL:** NINYO AND MOORE, 6700 PARADISE ROAD, SUITE E, LAS VEGAS, NV 89119 JMA ARCHITECTURE STUDIOS Management PP-404 FIRE & LIFE SAFETY: LASALLE ENGINEERING, 1000 YORK ROAD, WILLOW GROVE, PA 19090 A Joint Venture Department of Veterans Affairs MAD 357 of 512

PIP	E MATERIALS SCHEDULE
SERVICE	MATERIALS
DOMESTIC WATER	TYPE L COPPER ABOVE GRADE, TYPE K COPPER BELOW GRADE.
SOIL, WASTE AND VENT	CAST IRON SOIL PIPE WITH NO-HUB FITTINGS ABOVE GRADE, SCHEDULE 40 PVC WITH SOLVENT WELD FITTINGS BELOW GRADE.
STORM DRAIN	CAST IRON WITH NO-HUB FITTINGS ABOVE GRADE, SCHEDULE 80 PVC WITH SOLVENT WELD FITTINGS BELOW GRADE.
PUMPED SEWAGE	SCHEDULE 40 GALVANIZED STEEL WITH VICTAULIC COUPLINGS ABOVE GRADE, SCHEDULE 40 PVC WELD FITTINGS BELOW GRADE.

			P	LUMBII	NG FIX	TURE	SCHEDULE
ITEM	FIXTURE		ROUG	H-IN SIZES (II	NCHES)		NOTES
IIEM	FIXTURE	TW / HW	CW	VENT	TRAP	S OR W	INUIES
P-116	WATER CLOSET	_	1	2	_	4	WALL MOUNTED, BACK OUTLET, SENSOR OPERATED FLUSH VALVE
P-207	URINAL	-	1/2	2	2	2	WALL MOUNTED, SENSOR OPERATED FLUSH VALVE
P-420	LAVATORY	1/2	1/2	2	1-1/4 x 1-1/2	2	UNDERCOUNTER, SENSOR OPERATED FAUCET
P-421	LAVATORY	1/2	1/2	2	1-1/4 x 1-1/2	2	WALL MOUNTED, SENSOR OPERATED FAUCET
P-502	SERVICE SINK	3/4	3/4	_	3	3	24" x 24", FLOOR MOUNTED WITH CHECK AND SHUT-OFF VALVES
P-524	KITCHEN SINK	1/2	1/2	2	1-1/2	2	COUNTERTOP, DOUBLE COMPARTMENT, MANUAL FAUCET
P-525	KITCHEN SINK	3/4	3/4	2	3	_	FLOOR MOUNTED, THREE COMPARTMENT, MANUAL FAUCET, INDIRECT DRAIN TO FLOOR SINK
P-610	ELECTRIC WATER COOLER	_	1/2	2	1-1/4	2	WALL MOUNTED, BI-LEVEL, WITH BOTTLE FILLER AND CONDENSING UNIT
P-712	SHOWER	3/4	3/4	_	_	_	WALL MOUNTED, LOW FLOW SHOWER HEAD
P-811	HOSE BIBB	_	3/4	_	_	_	FREEZE-PROOF WITH LOCKING COVER

WATER HAI	MMER ARRE	STOR SCHEDULE
PIPE SIZE (INCHES)	PDI SYMBOL	NOTES
1/2	Α	2
3/4	Α	2
1	В	2
1-1/4	В	2
1-1/2	С	2
2	D	2
2-1/2	F	2

- 1. PDI = PLUMBING DRAINAGE INSTITUTE STANDARDS.
- 2. INSTALL PER MANUFACTURER'S RECOMMENDATIONS.

			STEAM	TO W	ATER	HE	AT E	XCH	ANGE	R SC	CHED	ULE	
ITEM	LOCATION	SERVICE	MANUFACTURER MODEL NUMBER	TYPE	FLOW (GPM)	CIRC FLUID	EWT (°F)	LUID LWT (°F)	MAX PD (FT)	STEAM ENTERING CONTROL VALVE	LINIERING	CONTROL VALVE (LBS/HR)	NOTES
WH 1	BASEMENT MECHANICAL ROOM	DOMESTIC HOT WATER	-	SHELL/TUBE	25	WATER	60	140	10	15	10	1,000	1, 2, 3, 4
$\frac{\text{WH}}{2}$	BASEMENT MECHANICAL ROOM	DOMESTIC HOT WATER	-	SHELL/TUBE	25	WATER	60	140	10	15	10	1,000	1, 2, 3, 4

- 1. PROVIDE 4" HIGH HOUSEKEEPING PAD.
- PROVIDE MANUFACTURER'S RECOMMENDED CLEARANCES FOR MAINTENANCE.
- 3. SYSTEM CONFIGURATION SHALL BE: 75% 75%.

\_\_\_\_\_

4. PROVIDE COMPLETE STEAM HEAT EXCHANGER PACKAGE ASME STAMPED FOR 150 PSIG WORKING PRESSURE WITH 316 STAINLESS STEEL TANK, DOUBLE WALLED HEAT EXCHANGER COMPLETE WITH FOAM IN PLACE INSULATION WATER PRESSURE GAUGE. ASME PRESSURE-TEMPERATURE RELIEF VALVE OF SUFFICIENT SIZE TO RELIEVE TOTAL BTU INPUT OF THE COIL, INCOMING STEAM STRAINER, ELECTRONIC CONTROL VALVE, FLOAT AND THERMOSTATIC STEAM TRAPS, CONDENSATE STRAINER. BRACES AND SUPPORTS AND CONTROLS FOR INTERFACE WITH EXISTING BUILDING MANAGEMENT SYSTEM. ENSURE THAT ALL COMPONENTS ARE PROVIDED FOR COMPLETE SYSTEM OPERATION.

#### WATER PIPE SIZING CHART

STATIC HEAD (SH) = 45 FEET x 0.43 = 19.35 PSI

PRESSURE AVAILABLE (PA) = 60 SERVICE PRESSURE - (19.35 (SH) + 35 REQ. PRESSURE + 0 METER) = 5.65 PSI (PA)

DEVELOPED LENGTH LONGEST RUN = 200 FEET 50 % FITTINGS LENGTH = 100 FEET

TOTAL EQUIVALENT LENGTH (TEL) = 300 FEET

ALLOWABLE FRICTION LOSS/100FT =  $100 \times 5.65 \text{ PSI (PA)}$  = 1.9 PSI/100FT

300 FT (TEL)

PIPE SIZE (INCHES)	MAXIMUM F	LOW (GPM)	FLUSH TA	ANK (FU)	FLUSH VA	ALVE (FU)	VELOCITY (FPS)		
PIPE SIZE (INCHES)	COLD WATER	HOT WATER	COLD WATER	HOT WATER	COLD WATER	HOT WATER	COLD WATER	HOT WATER	
1/2	1	1	1	1	_	_	1.5	1.5	
3/4	3	3	3	3	_	_	2.1	2.1	
1	6	6	7	7	_	_	2.5	2.5	
1-1/4	12	12	16	16	_	_	2.75	2.75	
1-1/2	18	18	26	26	5	_	3.1	3.1	
2	35	35	66	66	35	_	3.75	3.75	
2-1/2	65	_	205	_	90	_	4.2	_	
3	105	_	380	_	245	_	4.75	_	
4	_	_	_	_	_	_	_	_	

#### PLUMBING FIXTURE SPECIFICATIONS

#### PLUMBING FIXTURES

WATER CLOSET (P-116): WALL MOUNTED, REAR OUTLET, ELONGATED BOWL, 1.28 GPF, FLUSH VALVE, WHITE VITREOUS CHINA, TOP SPUD. LOW CONSUMPTION, TOP SPUD, 1.28 GPF, EXPOSED, BATTERY POWERED, SENSOR OPERATED FLUSH VALVE. ELONGATED, OPEN FRONT, WHITE SEAT WITH CHECK HINGES, ANTI-MICROBIAL AGENT, LESS COVER. (ADA COMPLIANT)

<u>URINAL (P-207)</u>: WALL MOUNTED, 0.125 GPF, FLUSH VALVE, WHITE VITREOUS CHINA, TOP SPUD, BLOW-OUT. LOW CONSUMPTION, TOP SPUD, 0.125 GPF, EXPOSED, BATTERY POWERED, SENSOR OPERATED FLUSH VALVE. (ADA COMPLIANT)

<u>LAVATORY (P-420):</u> UNDERCOUNTER MOUNTED, WHITE VITREOUS CHINA, 19" x 15" OVAL LAVATORY WITH OVERFLOW AND CLAMPS. 4" CENTERSET, 0.5 GPM, CHROME PLATED, BATTERY POWERED, SENSOR OPERATED LAVATORY FAUCET WITH CHROME PLATED GRID DRAIN. (ADA COMPLIANT)

LAVATORY (P-421): WALL MOUNTED, WITH VITREOUS CHINA, 4" CENTERS, 21-1/4" x 18-1/8" LAVATORY WITH OVERFLOW AND HANGER, 4" CENTERED 0.5 GPM, CHROME PLATED, BATTERY POWERED, SENSOR OPERATED LAVATORY FAUCET WITH CHROME PLATED GRID DRAIN. (ADA COMPLIANT).

SERVICE SINK (P-502): FLOOR MOUNTED, 24" x 24" x 12" HIGH, STAINLESS STEEL CAPS, 3" DRAIN OUTLET. WALL MOUNTED, 2.5 GPM, CHROME PLATED FAUCET WITH BUILT-IN STOPS, BOTTOM WALL BRACE AND CONTINUOUS VACUUM BREAKER NOZZLE.

<u>KITCHEN SINK (P-524)</u>: COUNTERTOP MOUNTED, TYPE 304 STAINLESS STEEL, 3-HOLES, 4" CENTERS,  $33" \times 22" \times 5^{1/2}$ " DEEP, DOUBLE COMPARTMENT SINK. 4" CENTERSET, CHROME PLATED, 2.2 GPM, 6" SWING FAUCET WITH 4" BLADE HANDLES. (2) TYPE 316 STAINLESS STEEL, BASKET STRAINER WITH METAL STEM AND RUBBER STOPPER. RUGGED GALVANIZED STEEL CONSTRUCTION GARBAGE DISPOSAL WITH DISHWASHER CONNECTION, 3/4 HORSEPOWER, 120 VOLT, SINGLE PHASE, 1725 RPM, 8.1 AMP AVERAGE LOAD WITH ON/OFF CONTROL WALL SWITCH. (ADA COMPLIANT)

KITCHEN SINK (P-525): FLOOR MOUNTED, 14" DEEP, 3-COMPARTMENT, 16 GAUGE 300 SERIES STAINLESS STEEL TOP AND BOWL, GALVANIZED LEGS AND ADJUSTABLE FEET, WELDED CONSTRUCTION, BACKSPLASH. WALL MOUNTED, 2.5 GPM, AND CHROME PLATED FAUCET WITH BUILT-IN STOPS.

<u>ELECTRIC WATER COOLER (P-610)</u>: <u>ELECTRIC BI-LEVEL WATER COOLER/BOTTLE FILLING</u> STATION, VANDAL RESISTANT BUBBLER, 1GPM FILL RATE, 8.0 GPH CAPACITY @ 90°F ROOM TEMP. WITH 115 V/10 COMPRESSOR. FURNISH WITH STOPS & TRAPS SAME AS LAVATORY.

SHOWER (P-712): THERMOSTATIC MIXING VALVE WITH INTEGRAL STOPS, SHOWER ARM WITH LOW FLOW SHOWER HEAD FOR 1.75 GPM.

#### SUPPLIES, TRAPS AND MISCELLANEOUS

SUPPLIES: FOR CONCEALED APPLICATIONS, CONNECT WATER CLOSETS, LAVATORIES AND SINKS WITH BALL VALVE ANGLE STOP WITH SS-16 16" STAINLESS STEEL CONNECTOR FOR LAVATORIES, SINKS; BALL VALVE ANGLE STOP WITH 12" STAINLESS STEEL CONNECTOR FOR WATER CLOSET. WHERE EXPOSED, PROVIDE CHROME PLATED FLEXIBLE TUBE-RISERS (PROVIDE OFFSET TAILPIECE AND INSULATE WASTE AND SUPPLIES AT ALL HANDICAPPED LAVATORIES AS REQUIRED.)

TRAPS: CHROME PLATED CAST BRASS WITH CLEANOUT PLUG AND TUBING OUTLET WITH TRAP ADAPTER AND ESCUTCHEON. PROVIDE OFFSET TAILPIECE AS REQUIRED.

CLEANOUT (CO): WALL, FLOOR INSIDE, OR FLOOR EXTERIOR CLEANOUT WITH SIZE AS NOTED ON FLOOR PLANS.

FLOOR DRAIN (FD): CAST IRON DRAIN BODY WITH FLASHING COLLAR AND ADJUSTABLE STRAINER HEAD. STRAINER FINISH SHALL BE NICKEL BRONZE UNLESS LOCATION REQUIRES GRATE TO MATCH APPLICABLE FIXTURE FINISHES AS IN TOILET ROOMS OR OUTDOOR APPLICATIONS. 11-1/2" CAST IRON GRATE (MECHANICAL ROOM, AND HEAVY TRAFFIC AREAS). SEE SPECIFICATION SECTION 22 13 00 FOR ADDITIONAL INFORMATION.

FLOOR SINK (FS): COMMERCIAL ENAMELING CAST IRON DRAIN, 10" DEEP WITH ENAMELED CAST IRON HALF GRATE EXCEPT WHERE INDICATED OTHERWISE ON PLUMBING DRAWINGS. SEE SPECIFICATION SECTION 22 13 00 FOR ADDITIONAL INFORMATION.

ROOF DRAIN (RD): CAST IRON BODY AND DOME WITH FLASHING COLLAR AND DOUBLE UNDER DECK CLAMP.

OVERFLOW ROOF DRAIN (ORD): CAST IRON BODY AND DOME WITH FLASHING COLLAR AND DOUBLE UNDER DECK CLAMP.

HOSE BIBB (HB): FREEZELESS HOSE BIBB WITH ANTI-SIPHON VACUUM BREAKER, 3/4" THREADED HOSE CONNECTION, REMOVABLE WHEEL HANDLE.

ICE MAKER BOX (IMB): STAINLESS STEEL, 1/2" x 1/4" COMPRESSION ANGLE STOP. FURNISH WITH 3'-0" OF 1/4" COILED TUBING.

DOWNSPOUT NOZZLE (DSN): NICKEL BRONZE BODY AND FLANGE. 

ANGLE STOP ARRESTOR (ASA): MINI-ANGLE STOP ARRESTOR, 3/8" COMPRESSION, CHROME PLATED.

ROOF RECEPTOR (RR): ROOF RECEPTOR WITH DAM, CAST IRON STRAINER AND UNDER DECK

#### **CONSTRUCTION DOCUMENTS BUILDING IS FULLY SPRINKLERED**

Drawing Title
Plumbing - Schedules **Project Number** CONSULTANTS: ADDENDUM 1 **ARCHITECT/ENGINEERS: KEY PLAN** Office of VA Medical Center - PHASE 593CA2202 Construction V, Administration Bldg. & **Building Number** SLATER HANIFAN GROUP, 5740 S. ARVILLE ST. #216, LAS VEGAS, NV 89118 Scale N.T.S. LANDSCAPE: and **Education Ctr. Addition** J W ZUNINO LANDSCAPE ARCHITECTURE, 3191 S. JONES BLVD., LAS VEGAS, NV 89146 RTKL JBA CONSULTING ENGINEERING, 5155 WEST PATRICK LANE, LAS VEGAS, NV 89118 **Facilities** STRUCTURAL: DEGENKOLB ENGINEERING, 235 MONTGOMERY STREET, SUITE 500, SAN FRANSISCO CA 94104 **Approved: Project Director** Drawing Number JMA ARCHITECTURE STUDIOS **GEOTECHNICAL:** NINYO AND MOORE, 6700 PARADISE ROAD, SUITE E, LAS VEGAS, NV 89119 North Las Vegas, NV Management PP-501 FIRE & LIFE SAFETY: LASALLE ENGINEERING, 1000 YORK ROAD, WILLOW GROVE, PA 19090 Checked Department of Veterans Affairs A Joint Venture 358 of 512

				EXPAI	NSION	TANK	SCHEDULE	
ITEM	MANUFACTURER / MODEL NUMBER	TYPE	APPLICATION	VOLUME (GALLONS)	LOCATION	PRECHARGE (PSIG)	MAXIMUM OPERATING WEIGHT (LBS)	NOTES
DET 1		BLADDER	DOMESTIC HOT WATER SYSTEM	106	MECHANICAL BASEMENT	45	1400	1, 2, 3
DET 2		BLADDER	SOLAR HOT WATER SYSTEM	10	MECHANICAL BASEMENT	45	150	1, 2, 3
DET 3		BLADDER	DOMESTIC COLD WATER SYSTEM	106	MECHANICAL BASEMENT	45	1400	1, 2, 3

. PROVIDE WITH BOTTOM NPT STAINLESS STEEL SYSTEM CONNECTION AND 0.302" - 32 CHARGING VALVE CONNECTION.

2. ASME STAMPED FOR 125 PSIG WATER PRESSURE, PRE-CHARGED, HEAVY DUTY, FDA APPROVED, REPLACABLE BUTYL BLADDER AND EPOXY LINED CONNECTIONS.

3. MOUNT ON 4" HOUSEKEEPING PAD.

	PUMP SCHEDULE												
ITEM	TYPE	LOCATION	FLOW	TDH	ELE	ECTRICAL		NOTES					
IIEM	IIFC	LOCATION	(GPM)	(FEET)	VOLTS/PHASE	HP	RPM	NOTES					
HCP 1	VERTICAL MULTISTAGE HOT WATER CIRCULATING PUMP	MECHANICAL BASEMENT	34	60	460/3	3	1750	1, 6, 8					
SP 1	DUPLEX SUBMERSIBLE SUMP PUMP (TWO PUMPS TOTAL)	ELEVATOR SUMP PIT	50 (EACH)	32 (EACH)	115/1	1/2 (EACH)	3450	4, 5, 6, 7					
SP 2	DUPLEX SUBMERSIBLE SUMP PUMP (TWO PUMPS TOTAL)	EXTERIOR STAIR WELL	10 (EACH)	20 (EACH)	115/1	1/2 (EACH)	-	4, 5, 6, 7					
SE 1	DUPLEX SUBMERSIBLE SUMP PUMP (TWO PUMPS TOTAL)	MECHANICAL BASEMENT	20 (EACH)	34 (EACH)	460/3	1 (EACH)	1750	2, 4, 6, 7					
SHCP 1	INLINE SOLAR LOOP PUMP (SOLAR WATER)	MECHANICAL BASEMENT	5	<b>4</b> 5	115/1	1/2	3500	1, 6, 8, 9					
SHCP 2	INLINE SOLAR LOOP PUMP (DOMESTIC WATER)	MECHANICAL BASEMENT	15	25	460/3	1	1750	1, 6, 8, 9					

- PROVIDE WITH STAINLESS STEEL OR BRONZE CONSTRUCTION, SUITABLE FOR USE IN DOMESTIC WATER SYSTEMS AND FLANGED BRONZE HOUSING
- 2. PROVIDE WITH CONTROL PANEL COMPLETE WITH HIGH LEVEL ALARM LIGHT, HORN, EXERCISE CIRCUIT, NON CLOG IMPELLER, PLUG IN CORD CONNECTION, AND NEMA 4X ENCLOSURE.
- 3. NOT USED -

VA FORM 08-623

- 4. PROVIDE WITH FLOAT SWITCH LEVEL CONTROL.
- 5. PROVIDE WITH CONTROL PANEL COMPLETE WITH HIGH LEVEL ALARM LIGHT, HORN, EXERCISE CIRCUIT, PLUG IN CORD CONNECTION, AND NEMA 4X ENCLOSURE.
- 6. PROVIDE WITH AUXILIARY DRY CONTACTS FOR DDC INTERFACE.
- 7. WIRING SHALL BE IDENTIFIED FOR USE IN WET LOCATIONS IN ACCORDANCE WITH THE NATIONAL ELECTRIC CODE.
- 8. PROVIDE SUPPLEMENTAL SUPPORT STEEL AND VIBRATION ISOLATION.
- 9. PROVIDE A COMPLETE SOLAR WATER HEATING SYSTEM FROM A SINGLE VENDOR FOR COMPLETE SYSTEM OPERATION AND CONTROL, INCLUDING VARIABLE SPEED PUMPING FOR SOLAR LOOP PUMPS. COORDINATE WITH SOLAR COLLECTOR SCHEDULE, STORAGE TANK SCHEDULE, AND SHEET PP-601 FOR ADDITIONAL INFORMATION.

	WATER METER SCHEDULE													
ITEM	MANUFACTURER / MODEL NUMBER	TYPE	LOCATION	SERVICE	METER SIZE (INCHES)	MAXIMUM PRESSURE DROP (PSIG)		MINIMUM FLOW RATE (GPM)		MAXIMUM CONTINUOUS OPERATING RANGE (GPM)	TEMPERATURE RANGE (*F)	MAXIMUM OPERATING WEIGHT (LBS)	NOTES	
WM 1		INLINE	BASEMENT	DOMESTIC COLD WATER	3	7	150	20	20 - 250	400	33 - 100	270	1, 2, 3	

- PROVIDE WITH ENCODER REGISTER INTERCONNECTED TO THE DDC SYSTEM. PRIOR TO PURCHASE, 3. METER AND COMPONENTS SHALL BE BACNET COMPATIBLE. CONTRACTOR SHALL VERIFY COMPATIBILITY WITH DDC SYSTEM.
- 2. FURNISH WITH INTERNAL STRAINERS, CLASS 150 FLANGES, BRONZE MAIN CASE AND INTERNAL BY-PASS SECTION FOR LOW FLOW.
- 4. REFER TO DETAIL 3/PP-403 FOR INSTALLATION.

	SOLAR WATER HEATING PANEL SCHEDULE														
ITEM	TYPE	LOCATION	SERVICE	GROSS AREA (SQ FT)	NET APERATURE AREA (SQ FT)	MAXIMUM TEST PRESSURE (PSIG)	FLUID CAPACITY (GALLONS)		LECTOR PERI PER CLEAR DAY	DAY	PER PANEL CLOUDY DAY		Y EQUATION LUES SLOPE	MAXIMUM OPERATING WEIGHT (LBS)	NOTES
SLP 1	GLAZED FLAT PLATE	ADMIN ROOF	SOLAR WATER HEATING	108.71	97.95	160	2.4	36	109.3 MBH	75.5 MBH	41.8 MBH	0.738	-0.722 BTU/HRxSQ FTx*F	550	1, 2, 3

3

- SRCC OG-100 CERTIFIED GLAZED FLAT PLATE SOLAR WATER HEATING COLLECTOR. PROVIDE WITH 3. COPPER TUBING AND ALUMINUM SHEET AND FRAME CONSTRUCTION WITH LOW IRON TEMPERED
- 2. FOR CLEAR DAYS USE 2000 BTU/SQ FTxDAY, FOR MILDLY CLOUDY USE 1500 BTU/SQ FTxDAY, AND FOR CLOUDY USE 1000 BTU/SQ FTxDAY FOR COLLECTOR THERMAL PERFORMANCE RATING.
- PROVIDE A COMPLETE SOLAR WATER HEATING SYSTEM FROM A SINGLE VENDOR FOR COMPLETE SYSTEM OPERATION AND CONTROL. INCLUDING A SOLAR PUMP STATION AND DIFFERENTIAL CONTROL UNIT WITH TEMPERATURE SENSORS FOR INTERFACE WITH THE EXISTING BUILDING MANAGEMENT SYSTEM AND REQUIRED ACCESSORIES THAT ARE MATCHED FOR THE SCHEDULED SOLAR COLLECTORS. COORDINATE WITH PUMP SHCP-1 TO MATCH THE SOLAR COLLECTOR FLOW RATE AND SHCP-2 TO MATCH THE HEAT EXCHANGER FLOW RATE WITHIN ST-1. ENSURE ALL ITEMS OF THE SYSTEM (STORAGE TANK <u>ST-1</u>, SOLAR LOOP PUMPS <u>SHCP-1</u> AND <u>SHCP-2</u>, SOLAR COLLECTOR <u>SLP-1</u> ARE PIPED AND PROVIDED WITH ACCESSORIES AS RECOMMENDED BY THE SOLAR WATER HEATING SYSTEM MANUFACTURER. SEE SHEET <u>PP-601</u> FOR PIPING DIAGRAM.

			EL	.ECTRO	NIC TRAP	PRIMER	SCHE	DULE			
ITEM	MANUFACTURER	LOCATION	TYPE	MOUNTING	MINIMUM MOUNTING	NUMBER OF DRAINS	INLET SIZE	MINIMUM HEADER	ELE	ECTRICAL	NOTES
	MODEL NUMBER		· · · <del>-</del>		HEIGHT (INCHES)		(INCHES)	CONNECTIONS	V/PH	FUSE (AMPS)	
ETP 1	-	BASEMENT MECHANICAL ROOM	ELECTRIC	WALL	12	4–30	3/4"	10	115V/1	2	1, 2, 3, 4, 5
ETP 2	-	IH145 HAC	ELECTRIC	WALL	12	4–30	3/4"	4	115V/1	2	1, 2, 3, 4, 5
ETP 3	-	1H108 HAC	ELECTRIC	WALL	12	4–30	3/4"	<b>1</b> 8	115V/1	2	1, 2, 3, 4, 5
ETP 4	_	2H208 HAC	ELECTRIC	WALL	12	4–30	3/4"	4	115V/1	2	1, 2, 3, 4, 5
ETP 5	_	3H308 HAC	ELECTRIC	WALL	12	4–30	3/4"	4	115V/1	2	1, 2, 3, 4, 5
ETP 6	_	3H308 HAC	ELECTRIC	WALL	12	4–30	3/4"	4	115V/1	2	1, 2, 3, 4, 5
ETP 7	-	3H308 HAC	ELECTRIC	WALL	12	4–30	3/4"	4	115V/1	2	1, 2, 3, 4, 5
ETP 8	-	3H308 HAC	ELECTRIC	WALL	12	4–30	3/4"	10	115V/1	2	1, 2, 3, 4, 5
ETP 9	-	3H308 HAC	ELECTRIC	WALL	12	4–30	3/4"	4	115V/1	2	1, 2, 3, 4, 5

- PROVIDE WITH ANTI-SIPHON VACUUM BREAKER, 24 HOUR CLOCK, MANUAL OVER RIDE, SOLENOID 4. PAINT ACCESS PANEL TO MATCH WALL. COORDINATE WITH ARCHITECT AND SPECIFICATIONS. VALVE, CALIBRATED MANIFOLD WITH 1/2" OUTLET COMPRESSION FITTINGS. VERIFY REQUIRED NUMBER OF OUTLETS WITH SPECIFIC LOCATION AND APPLICATION.
- - 5. VERIFY MOUNTING HEIGHT WITH FIELD CONDITIONS AND MANUFACTURER'S RECOMMENDATIONS.

- 2. PROVIDE SHUT-OFF VALVE ON INLET.
- 3. INSTALL PER MANUFACTURER'S RECOMMENDATIONS.

					INTE	ERCEF	TOR	SCHE	DULE			
ITEM	MANUFACTURER / MODEL NUMBER	TYPE	CAPACITY (GALLONS)	LOCATION	SIZE L x W x H (INCHES)	MANHOLE SIZE (INCHES)	MANHOLE SPACING (FEET)	INLET / OUTLET SIZE (INCHES)	MANUFACTURER / MODEL NUMBER	SAMPLE BOX SIZE (INCHES)	INLET / OUTLET SIZE (INCHES)	NOTES
S0 1	_	SAND/OIL INTERCEPTOR PRECAST CONCRETE	500	LANDSCAPE	72 x 48 x 70	24	10 MAX	4	PRECAST CONCRETE	24	3	1, 2, 3, 4

- PROVIDE INTERCEPTOR AND SAMPLE BOX WITH CAST IRON FRAMES AND GASKETED (GAS—TIGHT) 4. INTERCEPTOR AND SAMPLE BOX DESIGN SHALL BE FOR BURIAL NO DEEPER THAN 6'-0".
- 2. PROVIDE INTERCEPTOR AND SAMPLE BOX WITH RISERS AS REQUIRED TO MATCH SURROUNDING INLET/OUTLET CONNECTION.
- 3. INTERCEPTOR AND SAMPLE BOX SHALL BE CONSTRUCTED FOR H-20 TRAFFIC LOADING.

	STORAGE TANK SCHEDULE												
ITEM	TEM MANUFACTURER MODEL NUMBER TYPE APPLICATION VOLUME (GALLONS) SIZE (HEIGHT x DIAMETER) LOCATION OPERATING WEIGHT (LBS)												
$\left\langle \begin{array}{c} ST \\ 1 \end{array} \right\rangle$		VERITCAL	SOLAR BUFFER TANK	200	75 1/8" x 36 1/4"	MECHANICAL BASEMENT	2200	1, 2, 3, 4, 5					

- ASME STAMPED FOR 150 PSIG WATER PRESSURE AND CONFORM WITH ASHRAE 90.1 LATEST EDITION.
- 2. MOUNT ON 4" HOUSEKEEPING PAD.
- 3. PROVIDE WITH GLASS LINING, MAGNESIUM ANODES, 2" FOAM INSULATION, GALVANIZED JACKET FINISHED IN ENAMEL MANWAY INSPECTURE PAINT AND DRAIN CONNECTIONS.
- 4. PROVIDE WITH SEISMIC RETAINING STRAP.

5. PROVIDE WITH DOUBLE WALL HEAT EXCHANGER WITHIN TANK. COORDINATE HEAT EXCHANGER REQUIREMENTS WITH THE SOLAR WATER HEATING PANEL MANUFACTURE AND SOLAR PUMP MANUFACTURER. PROVIDE A COMPLETE SOLAR WATER HEATING SYSTEM FROM A SINGLE VENDOR FOR COMPLETE SYSTEM OPERATION AND CONTROL. COORDINATE WITH SOLAR COLLECTOR SCHEDULE, PUMP SCHEDULE, AND SHEET P-601 FOR ADDITIONAL INFORMATION.

## CONSTRUCTION DOCUMENTS **BUILDING IS FULLY SPRINKLERED**

ADDENDUM 1	08/15/12 CONSULTA	ANTS:	<b>KEY PLAN</b>	ARCHITECT/ENGINEERS:	Drawing Title Plumbing - Schedules	Project Title  VA Medical Center - PHASE	Project Number 593CA2202	Office of
	CIVIL: LANDSCAPE:	SLATER HANIFAN GROUP, 5740 S. ARVILLE ST. #216, LAS VEGAS, NV 89118 J W ZUNINO LANDSCAPE ARCHITECTURE, 3191 S. JONES BLVD., LAS VEGAS, NV 89146 JBA CONSULTING ENGINEERING. 5155 WEST PATRICK LANE. LAS VEGAS. NV 89118		RTKL	Scale N.T.S.	V, Administration Bldg. & Education Ctr. Addition	Building Number  6	Construction and
	STRUCTURAL: GEOTECHNICAL: FIRE & LIFE SAFETY:	DEGENKOLB ENGINEERING, 235 MONTGOMERY STREET, SUITE 500, SAN FRANSISCO CA 94104 NINYO AND MOORE, 6700 PARADISE ROAD, SUITE E, LAS VEGAS, NV 89119 LASALLE ENGINEERING, 1000 YORK ROAD, WILLOW GROVE, PA 19090		J M A A R CHITECTURE STUDIOS	Approved: Project Director	North Las Vegas, NV	Drawing Number PP-502	Facilities Manageme
dalama.		EAGALLE LIVOINELINING, 1000 TORR NOAD, WILLOW GROVE, FA 10000		A Joint Venture	Milan Arskin	Date Checked Drawn June 15, 2012 MTD MAD	359 of 512	Depa Veter

5 6 7

ITEM	MANUFACTURER	SYSTEM TYPE	I LOCATION	FLOW		DISCHARGE PRESSURE		i	PUMPS			ELECTRIC				NOTEC
	MODEL NUMBER		LOCATION	(GPM)	PRESSURE (PSIG)	(PSIG)	QUANTITY (TOTAL)	FLOW (GPM)	TDH (PSI)	HP	RICAL RPM	VOLTS/ PHASE	MCA	MOCP	OPERATING WEIGHT (LBS)	NOTES
BP 1	_	PACKAGED VERTICAL MULTI-STAGE		105	40	80	3	70 (2) 35 (1)	40 (EACH)	5 (2) 5 (1)	3,450 (EACH)	460/3	-	_	_	1, 2, 3, 4, 5, 6, 7, 8,
1. N	MANUFACTURER SHAL	L ACCOUNT FO	R INTERNAL SYS	STEM L	OSSES IN F	INAL PUMP S	SELECTIONS.	6							·	ISHED WITH INDIVIDUAL VARIABLE
	PROVIDE WITH AN 80									ENCY DE CH PUME	-	SOLATION	VALVE	S ON P	UMP INLET/OUT	TLET AND CHECK VALVE ON OUTLE
	FOR 125 PSIG WATER BUTYL BLADDER AND			EAVY [	OUTY, FDA A	APPROVED, R	EPLACABLE	7	. PROVIE	DE ISOLA	ATORS -	SEE VIBI	RATION	ISOLA	ΠΟΝ SCHEDULE.	•
	PROVIDE WITH FACTOR PUMP FAULT LIGHTS,							ITS, 8	. SYSTEI	M CONFI	GURATIO	N SHALL	BE: 6	7% – 6	7% – 33%	
4. F	PROVIDE WITH FULL S	SIZE STAINLESS	STEEL MANIFOLI	D.				9	. PROVIC	DE WITH	ALARM/	STATUS (	OUTPU'	T TO BI	MS/DDC CONTRO	OL SYSTEM.
5. N	MOUNT ON 4" HOUSE	KEEPING PAD.														
•																

			TE	MPI	ERING	STA	TIC	N SCHE	DUL	E	
	LOCATION	MANUFACTURER MODEL NUMBER		FLOW	SYSTEM PRESSURE DROP (PSIG)		R	RECIRCULATING PUMP	<b>D</b>		
ITEM			THERMOSTATIC MIXING VALVE	FLOW RATE (GPM)		FLOW RATE (GPM)	TDH (FT)	INLET/OUTLET SIZE (IN)	ELECTRICAL		NOTES
				(01 111)					V/PH	HP	
TS-1	BASEMENT MECHANICAL RM	_	HIGH/LOW	34	3	_	_	_	-	_	1

1. PROVIDE COMPLETE WITH VALVES, GAUGES, THERMOSTATS, AND GALVANIZED STEEL SUPPORT. INCLUDE OPTION FOR LEGS TO FLOOR.

# CONSTRUCTION DOCUMENTS BUILDING IS FULLY SPRINKLERED

Project Number Office of VA Medical Center - PHASE 593CA2202 Construction V, Administration Bldg. & Building Number and Education Ctr. Addition **Facilities** Location
North Las Vegas, NV Drawing Number Management **PP-503** Checked Drawn Department of Veterans Affairs MAD 360 of 512

1 ADDENDUM 1	08/15/12	CON
		COI
		CIVIL:
		LANDSO
		MEP: STRUC1
		GEOTE
		FIRE & I
Revisions:	Date:	

CONSULTANTS:

CIVIL: SLATER HANIFAN GROUP, 5740 S. ARVILLE ST. #216, LAS VEGAS, NV 89118

LANDSCAPE: J W ZUNINO LANDSCAPE ARCHITECTURE, 3191 S. JONES BLVD., LAS VEGAS, NV 89146

MEP: JBA CONSULTING ENGINEERING, 5155 WEST PATRICK LANE, LAS VEGAS, NV 89118

STRUCTURAL: DEGENKOLB ENGINEERING, 235 MONTGOMERY STREET, SUITE 500, SAN FRANSISCO CA 94104

GEOTECHNICAL: NINYO AND MOORE, 6700 PARADISE ROAD, SUITE E, LAS VEGAS, NV 89119

FIRE & LIFE SAFETY: LASALLE ENGINEERING, 1000 YORK ROAD, WILLOW GROVE, PA 19090

TRIKL

J M A A R CHITECTURE STUDIOS

A Joint Venture

ARCHITECT/ENGINEERS:

**KEY PLAN** 

Approved: Project Director

Mulan Ara

Scale N.T.S.

Drawing Title
Plumbing - Schedules

